

CERTIFICATE OF LOCATION OF GOVERNMENT CORNER

County of Anoka


State of Minnesota

1/4 CORNER ON NORTH LINE OF SOUTH WEST 1/4 Corner of Sec. 9 Township 33 Range 22

I hereby certify that on the 5 day of June, 1986, I found the described corner which was evidenced by AREA RESURVEY

and I further certify that to perpetuate the location of said corner, I did, at the exact location thereof, place a permanent marker consisting of 1/2" IRON PIPE

which reference or witness monuments are located in the manner following:

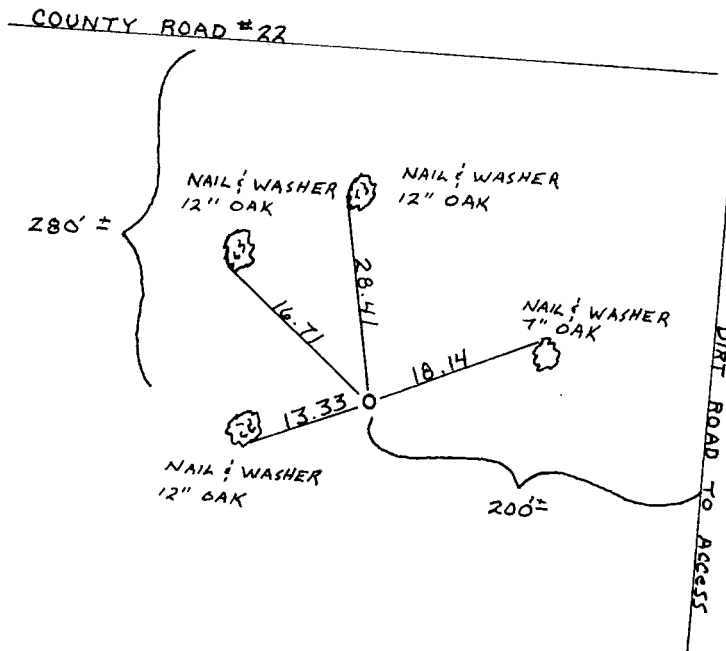

Revised date
8-18-87

By
D. ROSS

Minnesota State Plane Coordinates
 South Zone
 Y _____ X _____
 _____ , _____
 County Surveyor Date
 Registered Land Surveyor No. _____