
Page No.	46 A
90	10 7

## CERTIFICATE OF LOCATION OF GOVERNMENT CORNER

County of Anoka

State of Minnesota

EYIL of NE 1/4 Corner of Sec. 12 Township 33 Range 22
I hereby certify that on the// day of, 1975, I found the described corner which was evidenced by _CONCRETE STEEL POST EAST SIDE
and I further certify that to perpetuate the location of said corner, I did, at the exact location thereof, place a permanent marker consisting of SAIME, SIGNANO
POST ON NORTH SIDE which reference or witness monuments are located in the manner following:

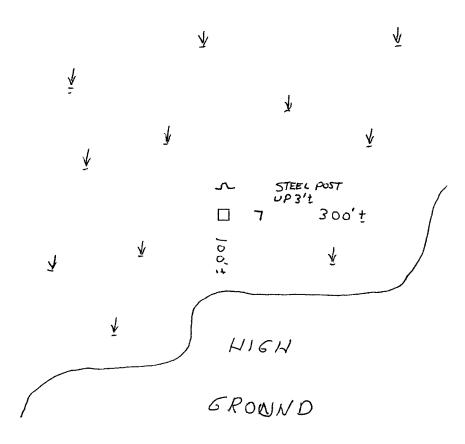

Revised date	Revised date	Revised date
·		

