

CERTIFICATE OF LOCATION OF GOVERNMENT CORNER

County of Anoka

State of Minnesota

Meander Corner of Sec. 9 Township 33 Range 22



(MC #21 on south line of SW 1/4)

On the 27th day of August, 1964, the described corner was evidenced by a 6" X 6" granite monument

and to perpetuate the location of said corner, at the exact location thereof, a permanent marker was placed consisting of the same granite monument with a sign and post on the north side

AND on the 27th day of November, 2013, said permanent marker was found and the ties were updated

Updated reference ties are as shown below.

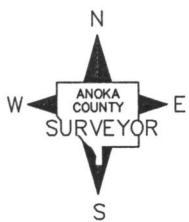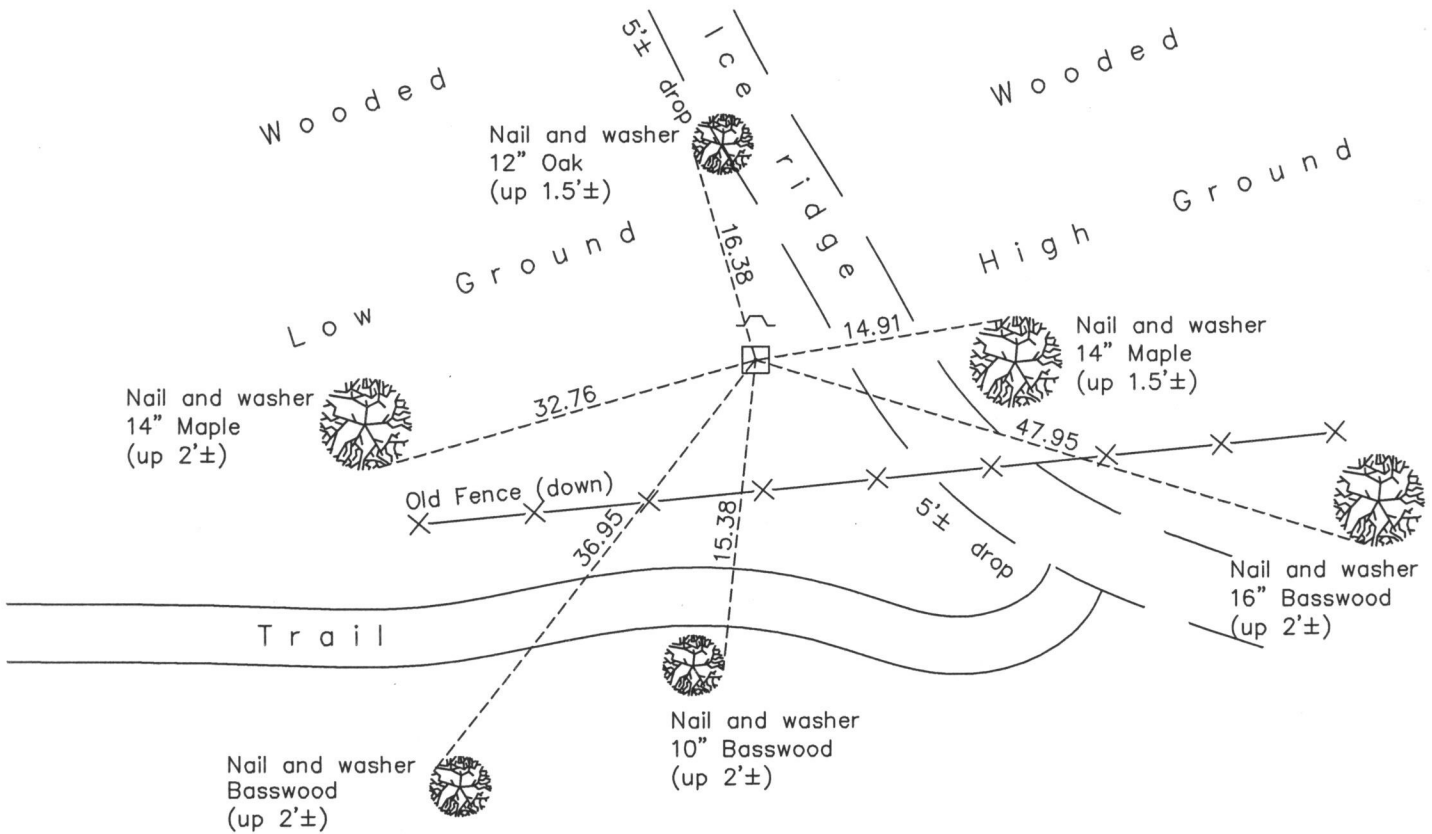

Revision Date
8/28/15

N.A.D. 1983 Coordinates
(1996 Adjustment)

County Project Coordinates	
Northing	216795.7761
Easting	544681.8552
Date	5/12/04

I hereby certify that this United States public land survey monument record is correct and complete to the best of my knowledge and belief.

Larry D. Hoium Date 8/28/15

Larry D. Hoium, Anoka County Surveyor
Minnesota License Number 18165