

# CERTIFICATE OF LOCATION OF GOVERNMENT CORNER

County of Anoka

State of Minnesota


## South 1/4 Corner of Sec. 13 Township 33 Range 22

On the 15th day of October, 1968, the described corner was evidenced by a granite monument found using Hult ties

and to perpetuate the location of said corner, at the exact location thereof, a permanent marker was placed consisting of the same granite monument with an iron pipe set on the north side

AND on the 8th day of April, 2014, said permanent marker was found down 1'± and the ties were updated

Updated reference ties are as shown below.

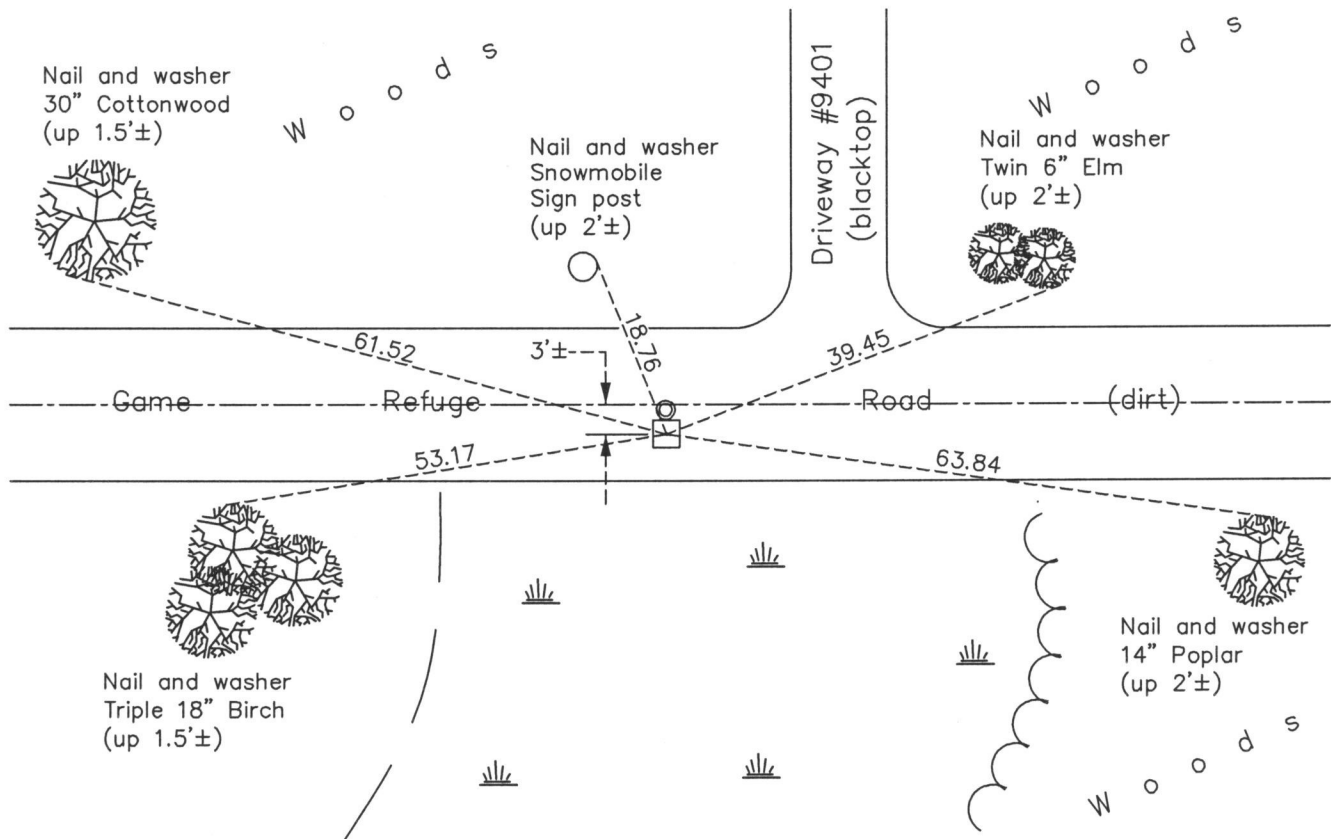

N

S

ANOKA COUNTY SURVEYOR

Revision Date

9/01/15

N.A.D. 1983 Coordinates  
(1996 Adjustment)

County Project Coordinates	
Northing	<u>211289.9112</u>
Easting	<u>560845.6110</u>
Date	<u>5/05/04</u>

I hereby certify that this United States public land survey monument record is correct and complete to the best of my knowledge and belief.

*Larry D. Hoium* Date 9/01/15

Larry D. Hoium, Anoka County Surveyor  
Minnesota License Number 18165