

# CERTIFICATE OF LOCATION OF GOVERNMENT CORNER

County of Anoka

State of Minnesota


## Southeast Corner of Sec. 15 Township 33 Range 22

On the 30th day of July, 1975, the described corner was evidenced by a granite monument with 1/2" iron pipes on the north and south sides

and to perpetuate the location of said corner, at the exact location thereof, a permanent marker was placed consisting of a cast iron monument (down 1.5'±) on top of the granite monument (down 4'±)

AND on the 8th day of April, 2014, said permanent marker was found and the ties were updated

Updated reference ties are as shown below.

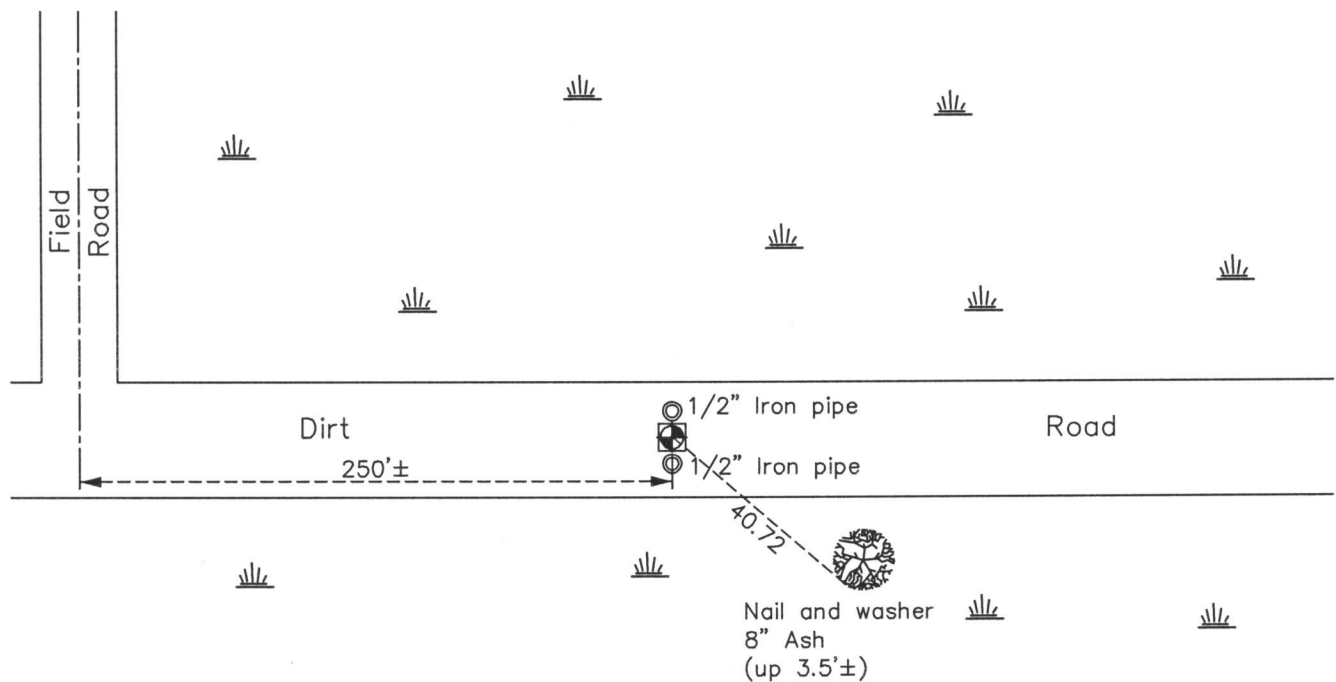

N

W ANOKA COUNTY SURVEYOR E

S

Revision Date

9/01/15

N.A.D. 1983 Coordinates  
(1996 Adjustment)

County Project Coordinates	
Northing	<u>211529.4686</u>
Easting	<u>552817.1347</u>
Date	<u>5/05/04</u>

I hereby certify that this United States public land survey monument record is correct and complete to the best of my knowledge and belief.

Date 9/01/15

Larry D. Hoium, Anoka County Surveyor  
 Minnesota License Number 18165