

# CERTIFICATE OF LOCATION OF GOVERNMENT CORNER

County of Anoka


State of Minnesota

1/16 COR. ON WEST Corner of Sec. 24 Township 33 Range 22  
LINE OF S.W. 1/4

I hereby certify that on the 2 day of MARCH, 1976, I found the described corner which was evidenced by 1" BOLT

and I further certify that to perpetuate the location of said corner, I did, at the exact location thereof, place a permanent marker consisting of SAME, SIGN AND POST ON NORTH SIDE

which reference or witness monuments are located in the manner following:

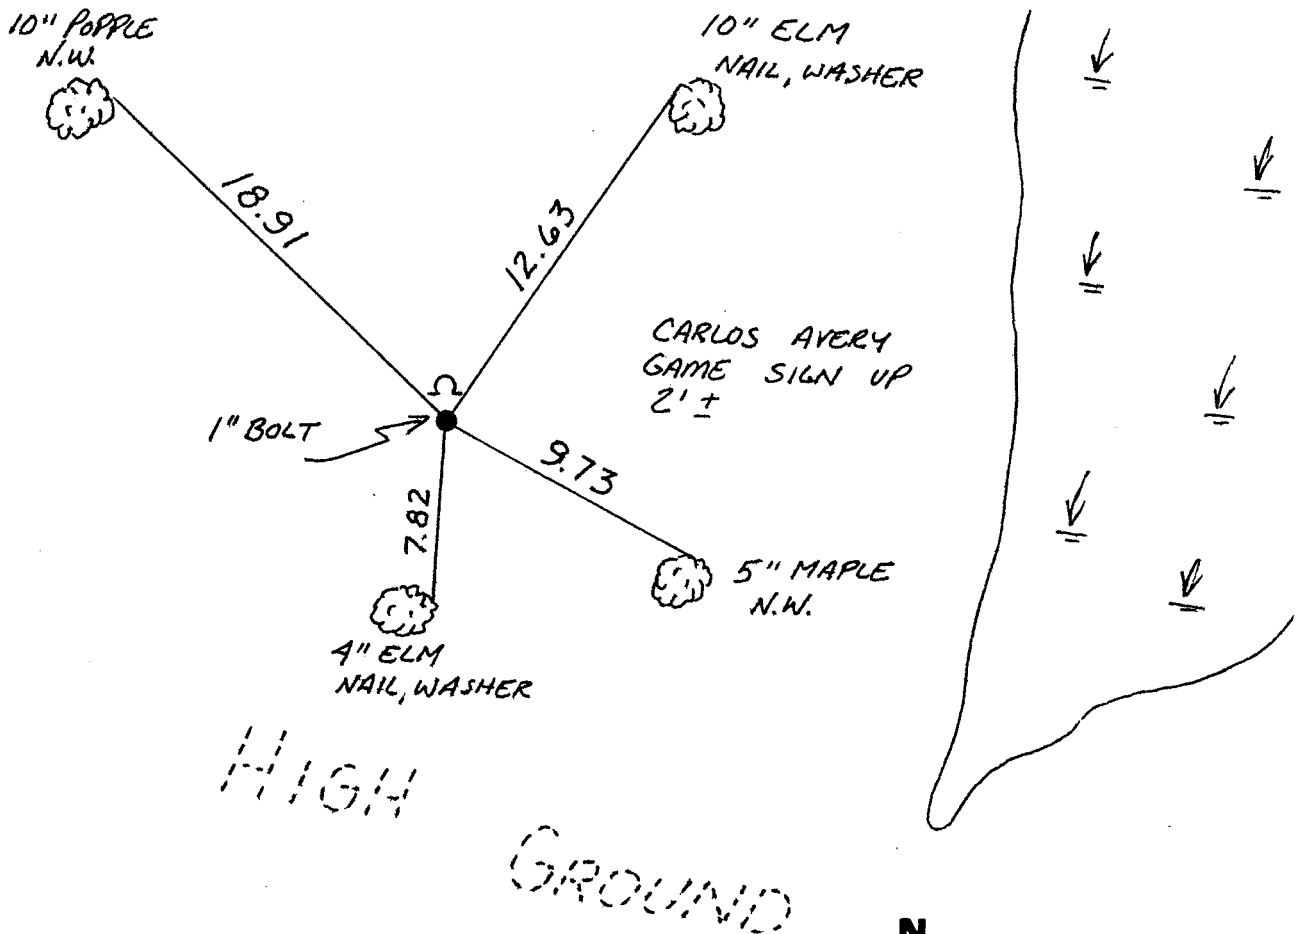

| Revised date | Revised date | Revised date |
|--------------|--------------|--------------|
|              |              |              |
|              |              |              |
