

CERTIFICATE OF LOCATION OF GOVERNMENT CORNER

County of Anoka


State of Minnesota

N.W. COR. OF
N.E. 1/4 OF N.E. 1/4 Corner of Sec. 30 Township 33 Range 22

I hereby certify that on the 16 day of APRIL, 1973, I found the described corner which was evidenced by AREA RESURVEY

and I further certify that to perpetuate the location of said corner, I did, at the exact location thereof, place a permanent marker consisting of CAST IRON

which reference or witness monuments are located in the manner following:

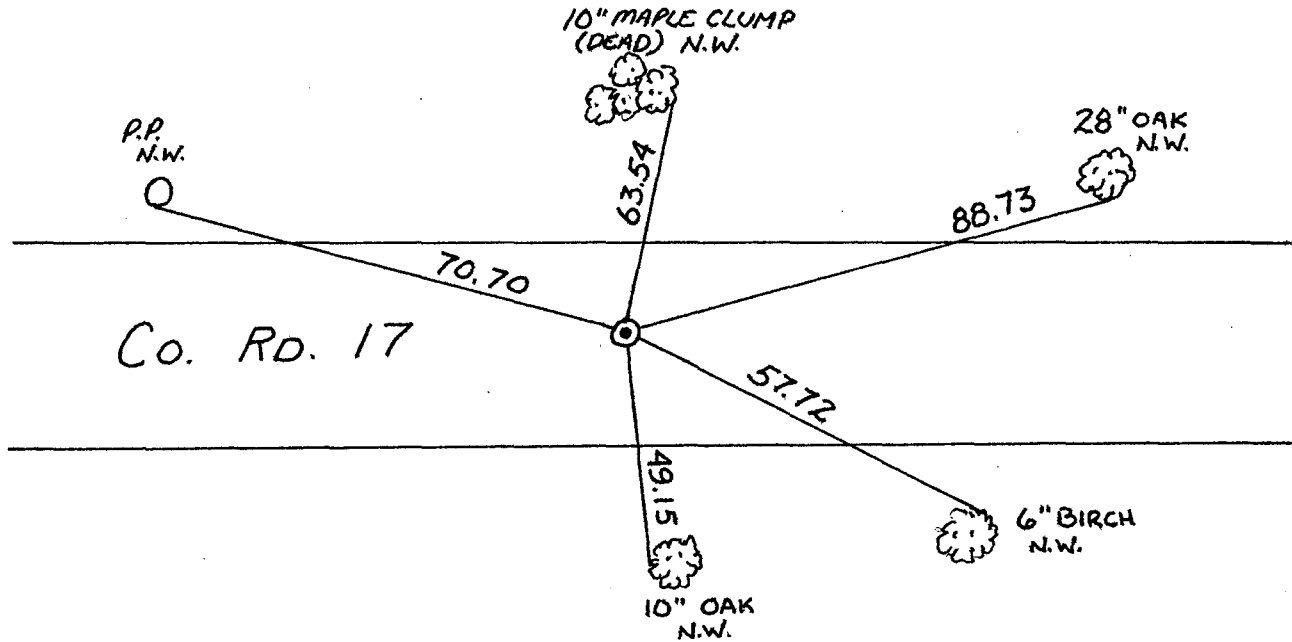

Revised date	Revised date	Revised date
8-5-87		
6-15-93		

