

CERTIFICATE OF LOCATION OF GOVERNMENT CORNER

County of Anoka

State of Minnesota


East 1/4 Corner of Sec. 30 Township 33 Range 22

On the 16th day of April, 1973, the described corner was evidenced by area resurvey

and to perpetuate the location of said corner, at the exact location thereof, a permanent marker was placed consisting of a cast iron monument

AND on the 8th day of May, 2014, said permanent marker was found down 0.5'± and the ties were updated. Set sign and post on east side of monument facing west.

Updated reference ties are as shown below.

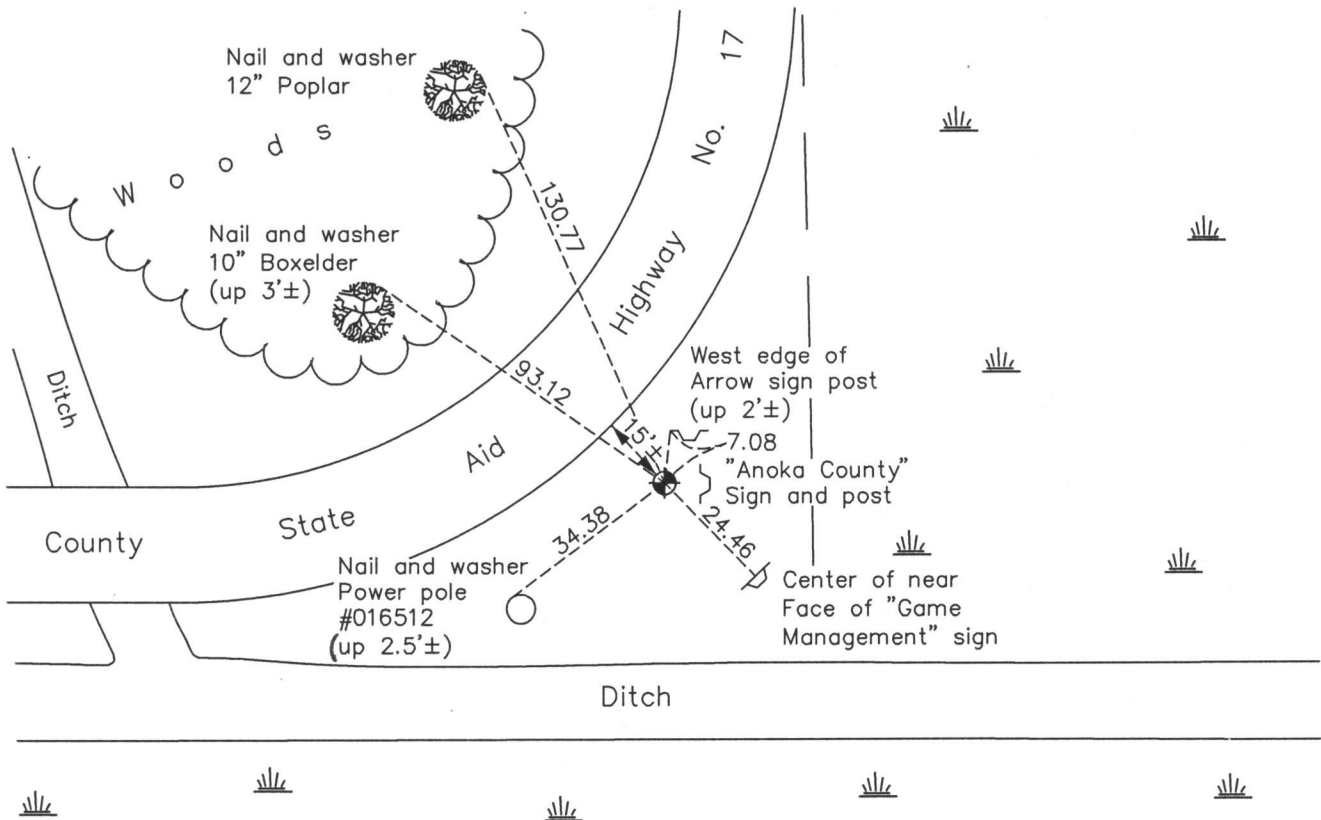

ANOKA COUNTY SURVEYOR

Revision Date

9/17/15

N.A.D. 1983 Coordinates
(1996 Adjustment)

County Project Coordinates	
Northing	<u>203492.3677</u>
Easting	<u>537026.8575</u>
Date	<u>7/01/03</u>

I hereby certify that this United States public land survey monument record is correct and complete to the best of my knowledge and belief.

Larry D. Hoium Date 9/17/15

Larry D. Hoium, Anoka County Surveyor

Minnesota License Number 18165