

CERTIFICATE OF LOCATION OF GOVERNMENT CORNER

County of Anoka


State of Minnesota

S. 1/16 COR. OF S.W. 1/4 Corner of Sec. 25 Township 33 Range 22

I hereby certify that on the 11 day of SEPT., 1968, I found the described corner which was evidenced by CONCRETE FROM D. HULT TIES

and I further certify that to perpetuate the location of said corner, I did, at the exact location thereof, place a permanent marker consisting of SAME

which reference or witness monuments are located in the manner following:

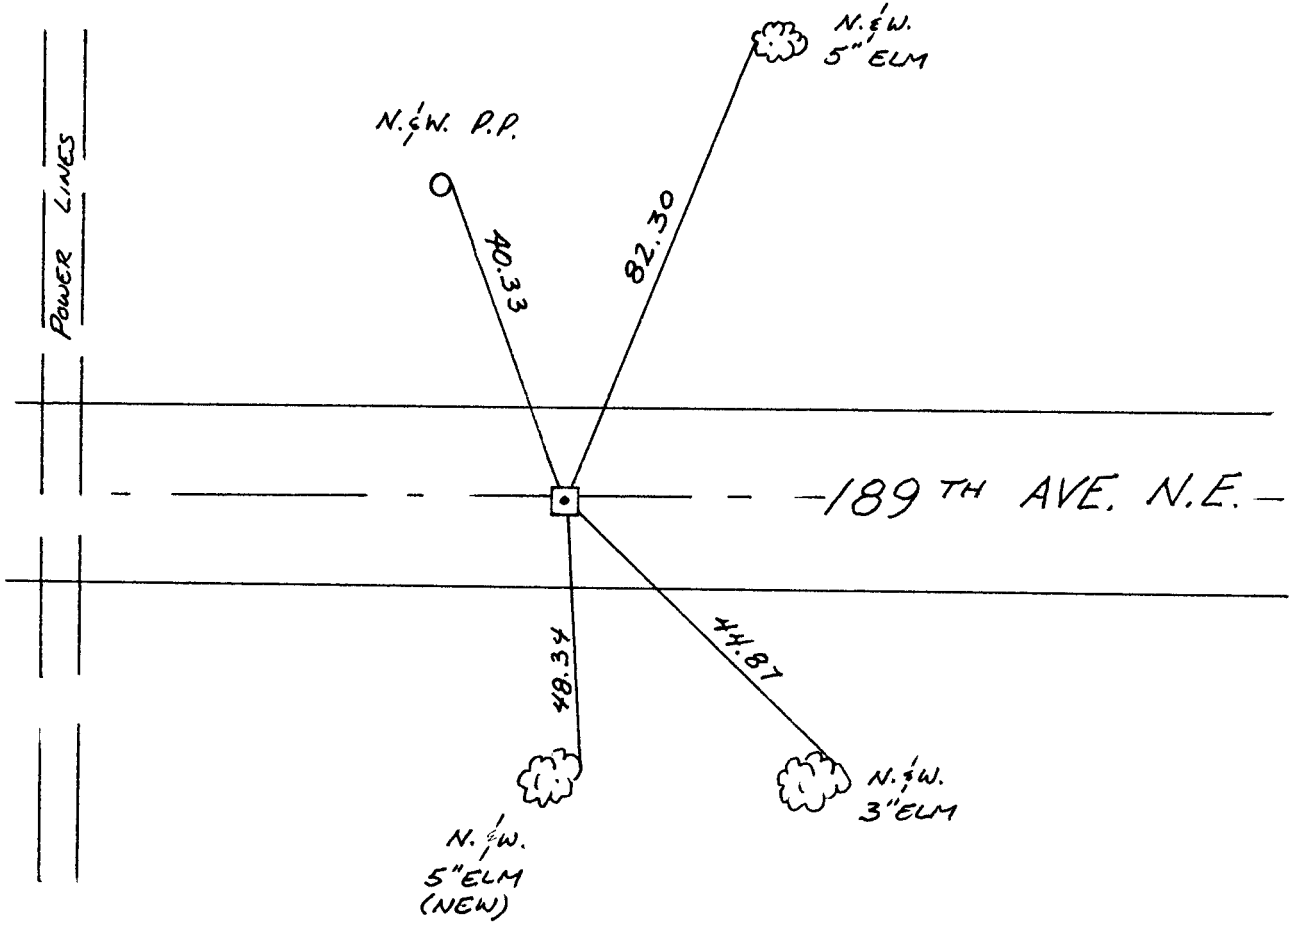

Revised date	Revised date	Revised date
11-2-90		

