

# CERTIFICATE OF LOCATION OF GOVERNMENT CORNER

County of Anoka


State of Minnesota

One Sixteenth Corner  
on North line of South WEST One Quarter Corner of Sec. 35 Township 33 Range 22

I hereby certify that on the 8 day of January, 1985, I found the described corner which was evidenced by CONCRETE

and I further certify that to perpetuate the location of said corner, I did, at the exact location thereof, place a permanent marker consisting of concrete monument with Carlos Avey's

which reference or witness monuments are located in the manner following:

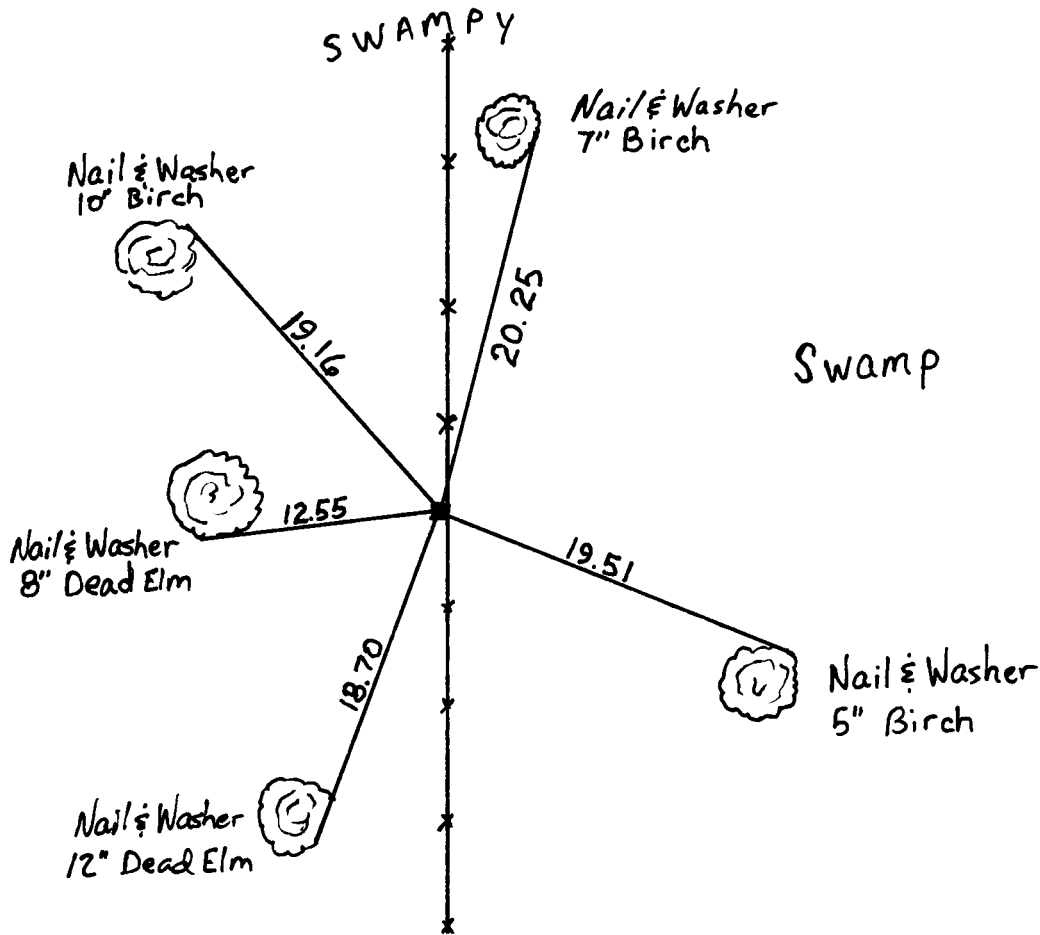

Revised date

By

Minnesota State Plane Coordinates  
South Zone

Y \_\_\_\_\_ X \_\_\_\_\_

\_\_\_\_\_,  
County Surveyor Date

Registered Land Surveyor No. \_\_\_\_\_