

# CERTIFICATE OF LOCATION OF GOVERNMENT CORNER

County of Anoka

State of Minnesota

## Witness Corner of Sec. 36 Township 33 Range 22



(on east line of section)

On the 2nd day of August, 1966, the described corner was evidenced by area resurvey

and to perpetuate the location of said corner, at the exact location thereof, a permanent marker was placed consisting of a cast iron monument

AND on the 8th day of September, 2014, said permanent marker was found to be an Anoka County cast iron monument with a Chisago County sign & post on the north side. Ties were updated.

Updated reference ties are as shown below.

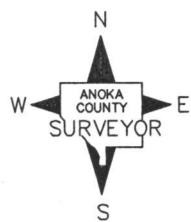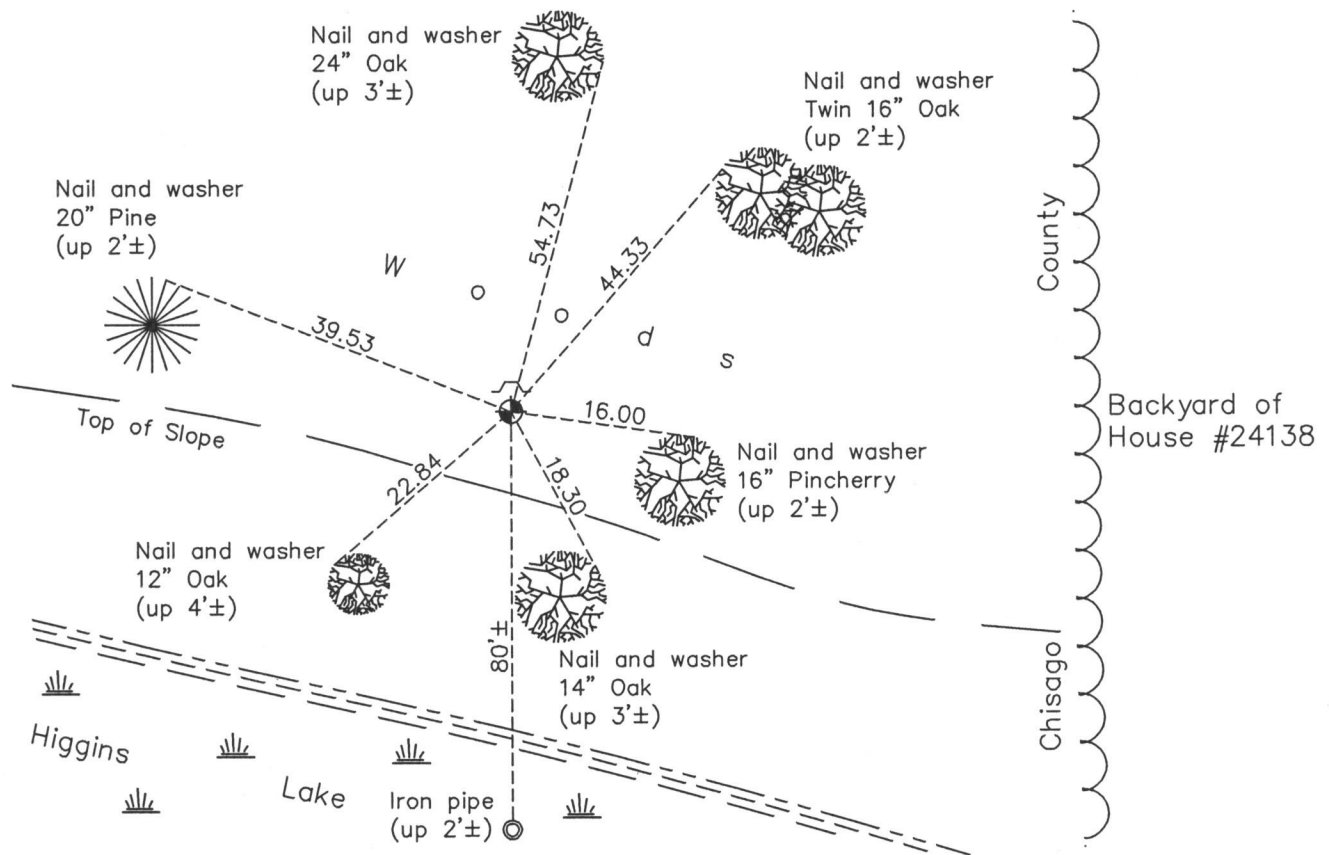

Revision Date  
9/25/15

N.A.D. 1983 Coordinates  
(1996 Adjustment)

County Project Coordinates	
Northing	196100.8329
Easting	563590.3496
Date	5/27/04

I hereby certify that this United States public land survey monument record is correct and complete to the best of my knowledge and belief.

*Larry D. Hoium* Date 9/25/15

Larry D. Hoium, Anoka County Surveyor  
Minnesota License Number 18165