

CERTIFICATE OF LOCATION OF GOVERNMENT CORNER

County of Anoka

State of Minnesota



Witness Corner of Sec. 25 Township 34 Range 22
(on north line of NW 1/4)

On the 28th day of May, 1975, the described corner was evidenced by area resurvey

and to perpetuate the location of said corner, at the exact location thereof, a permanent marker was placed consisting of a cast iron monument with a sign and post on the north side

AND on the 25th day of April, 2014, said permanent marker was found 0.4'± under the surface of the water and the ties were updated

Updated reference ties are as shown below.

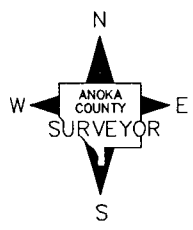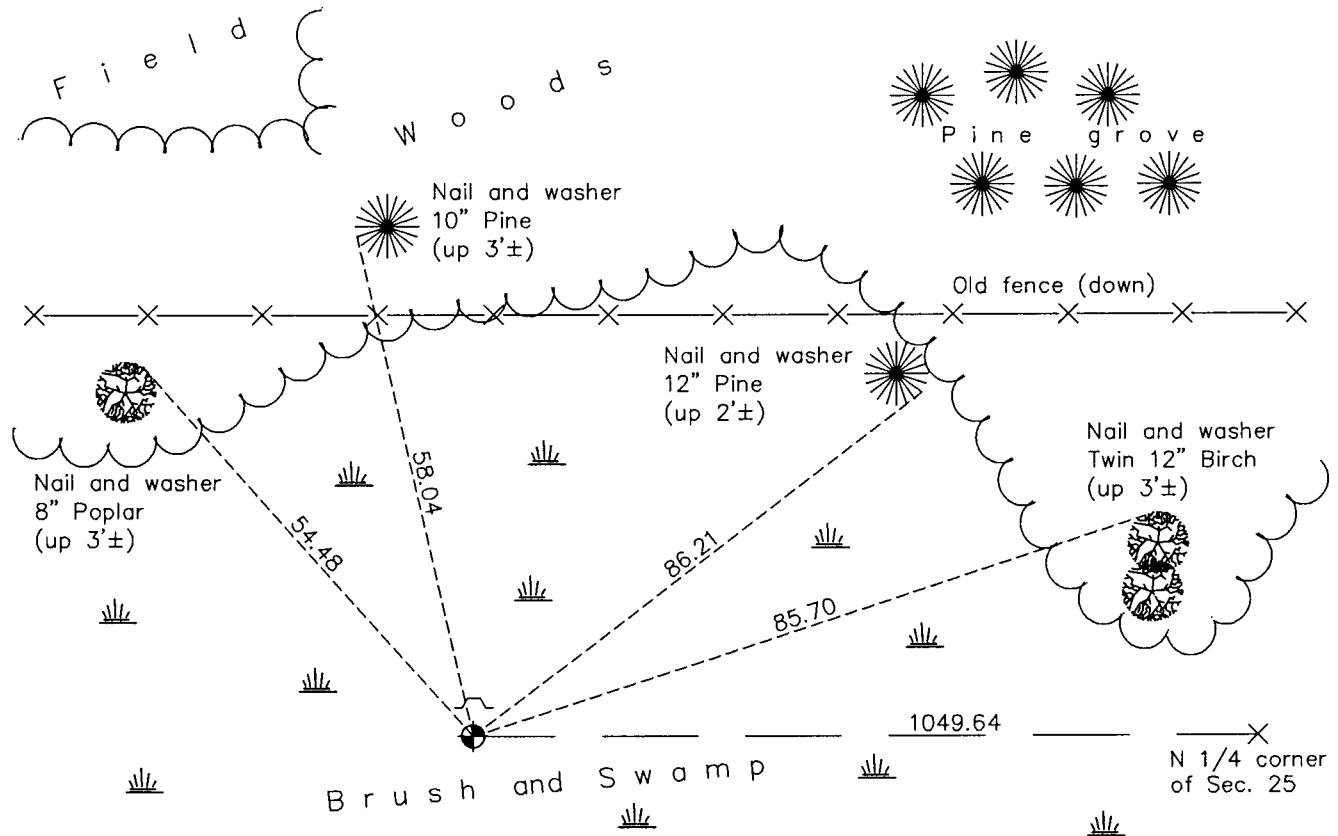

Revision Date
11/05/15

N.A.D. 1983 Coordinates
(1996 Adjustment)

County Project Coordinates	
Northing	<u>237447.5807</u>
Easting	<u>559760.3235</u>
Date	<u>3/18/04</u>

I hereby certify that this United States public land survey monument record is correct and complete to the best of my knowledge and belief.

Larry D. Hoium Date 11/05/15
 Larry D. Hoium, Anoka County Surveyor
 Minnesota License Number 18165