

# CERTIFICATE OF LOCATION OF GOVERNMENT CORNER

County of Anoka

State of Minnesota



## Northwest Corner of Sec. 26 Township 34 Range 22

On the 19th day of August, 1966, the described corner was evidenced by a cast iron monument

and to perpetuate the location of said corner, at the exact location thereof, a permanent marker was placed consisting of a red and white iron pipe

AND on the 14th day of February, 2014, said permanent marker was found up 4'± and leaning southeasterly. The ties were updated.

Updated reference ties are as shown below.

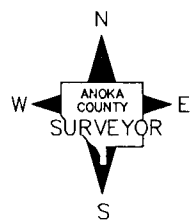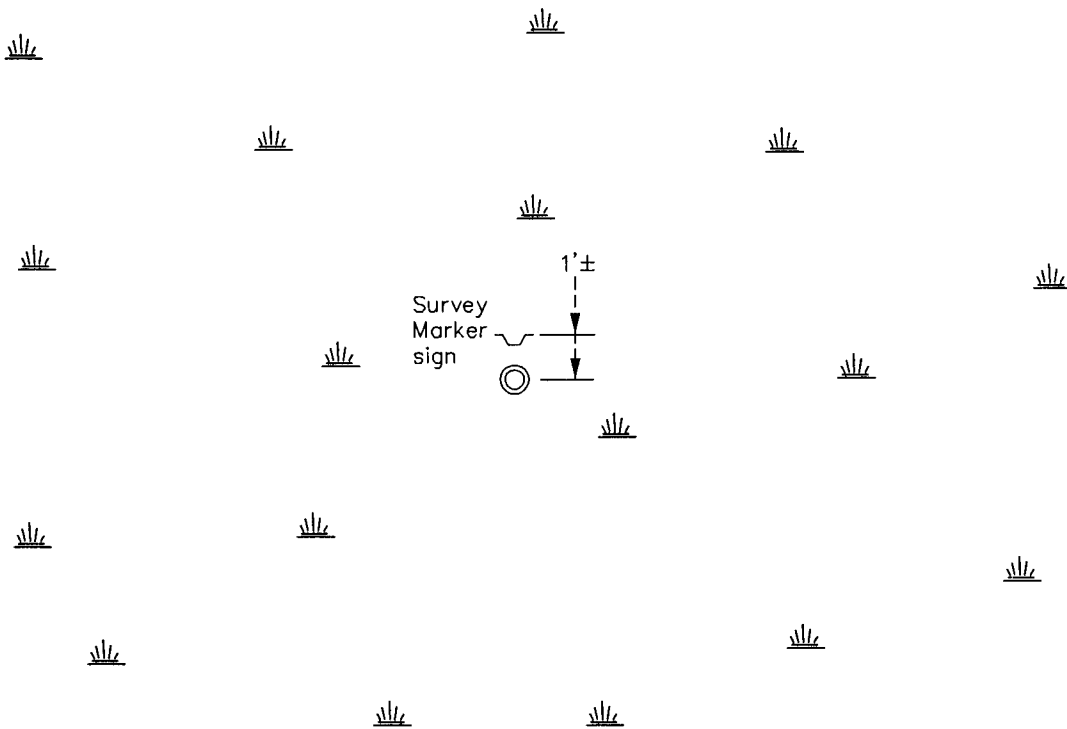

Revision Date  
11/05/15

N.A.D. 1983 Coordinates  
(1996 Adjustment)

County Project Coordinates	
Northing	<u>237635.7458</u>
Easting	<u>552941.0892</u>
Date	<u>2/19/04</u>

I hereby certify that this United States public land survey monument record is correct and complete to the best of my knowledge and belief.

*Larry D. Hoium* Date 11/05/15

Larry D. Hoium, Anoka County Surveyor

Minnesota License Number 18165