

# CERTIFICATE OF LOCATION OF GOVERNMENT CORNER

County of Anoka

State of Minnesota



## Northwest Corner of Sec. 27 Township 34 Range 22

On the \_\_\_\_ day of July, 1960, the described corner was evidenced by an Isanti  
County cast iron monument

and to perpetuate the location of said corner, at the exact location thereof, a permanent marker was placed consisting of a cast iron monument with a sign and post on the north side

AND on the 3rd day of February, 2014, said permanent marker was found and the ties were updated

Updated reference ties are as shown below.

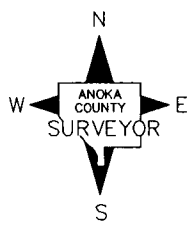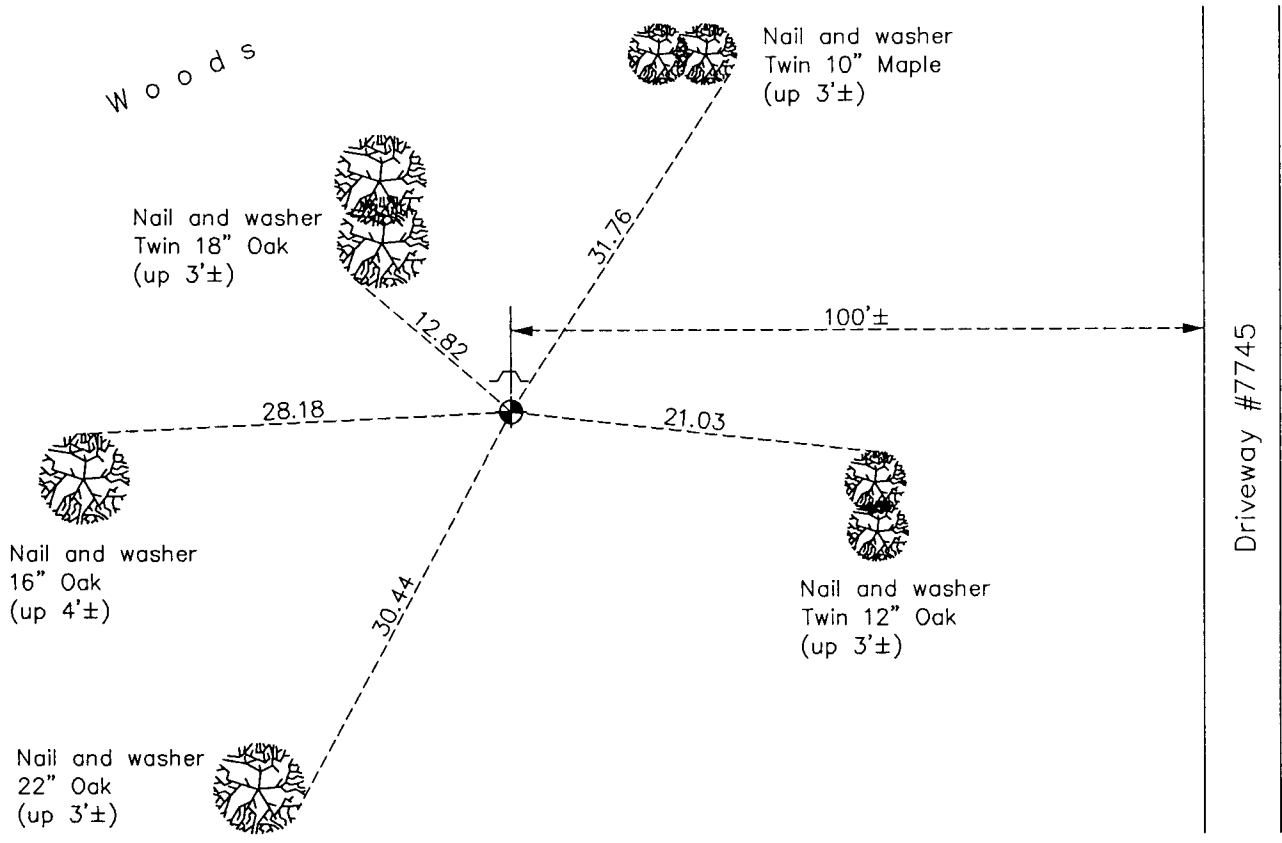

Revision Date  
11/24/15

N.A.D. 1983 Coordinates  
 (1996 Adjustment)

County Project Coordinates	
Northing	237747.2745
Easting	547628.0739
Date	1/08/04

I hereby certify that this United States public land survey monument record is correct and complete to the best of my knowledge and belief.

*Larry D. Hoium* Date 11/24/15

Larry D. Hoium, Anoka County Surveyor

Minnesota License Number 18165