

# CERTIFICATE OF LOCATION OF GOVERNMENT CORNER

County of Anoka

State of Minnesota


Witness Corner of Sec. 28 Township 34 Range 22  
(on north line of section)

On the 4th day of April, 1979, the described corner was evidenced by area resurvey

and to perpetuate the location of said corner, at the exact location thereof, a permanent marker was placed consisting of a cast iron monument with a sign and post on the north side

AND on the 14th day of January, 2014, said permanent marker was found flush with the ground and the ties were updated

Updated reference ties are as shown below.

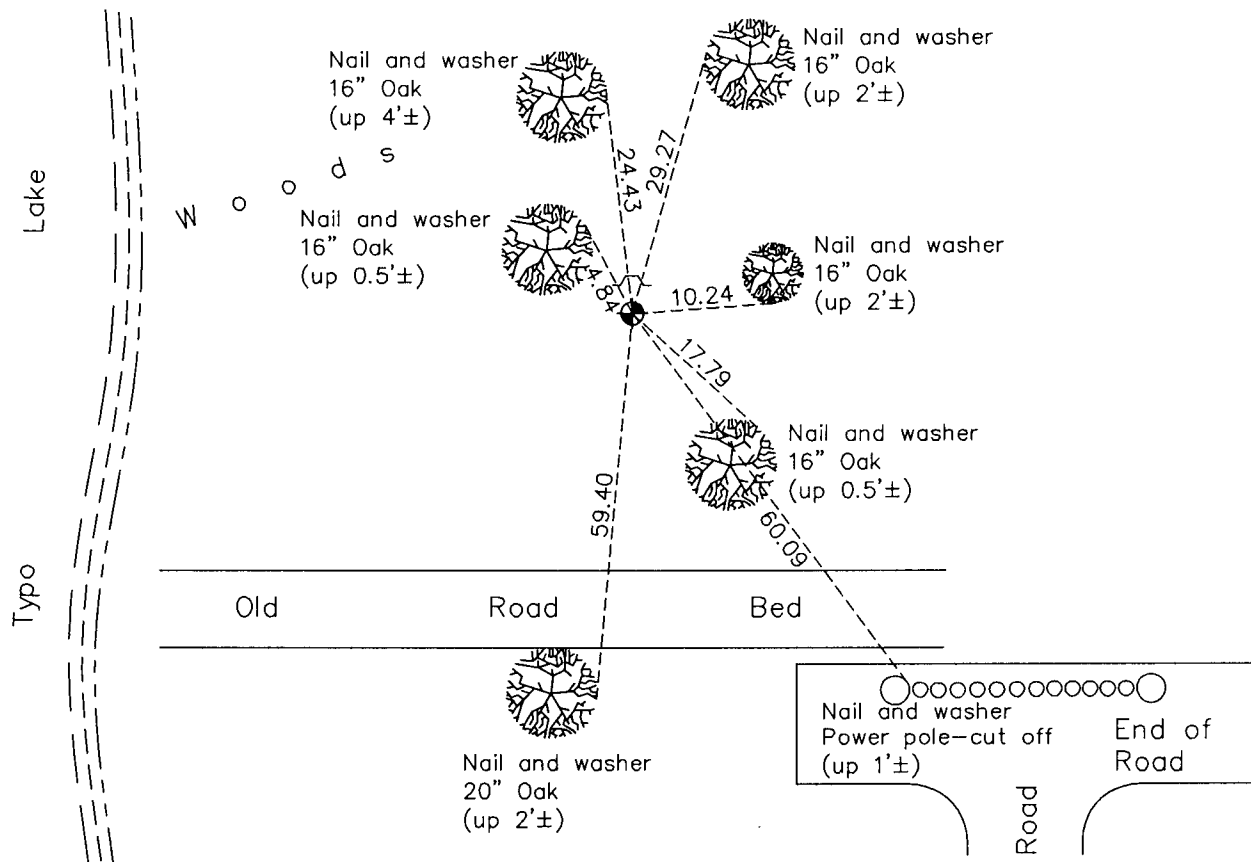

N  
  
 W E  
 S

Revision Date  
12/07/15

N.A.D. 1983 Coordinates  
(1996 Adjustment)

County Project Coordinates	
Northing	237757.7087
Easting	547229.6365
Date	1/06/04

I hereby certify that this United States public land survey monument record is correct and complete to the best of my knowledge and belief.

*Larry D. Hoium* Date 12/07/15

Larry D. Hoium, Anoka County Surveyor  
 Minnesota License Number 18165