

CERTIFICATE OF LOCATION OF GOVERNMENT CORNER

County of Anoka

State of Minnesota



Witness Corner of Sec. 28 Township 34 Range 22
(on north line of section)

On the 12th day of February, 1979, the described corner was evidenced by area resurvey

and to perpetuate the location of said corner, at the exact location thereof, a permanent marker was placed consisting of a cast iron monument

AND on the 2nd day of May, 2014, said permanent marker was found with a sign and post on the north side and the ties were updated

Updated reference ties are as shown below.

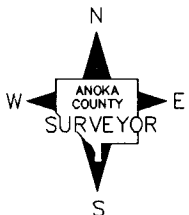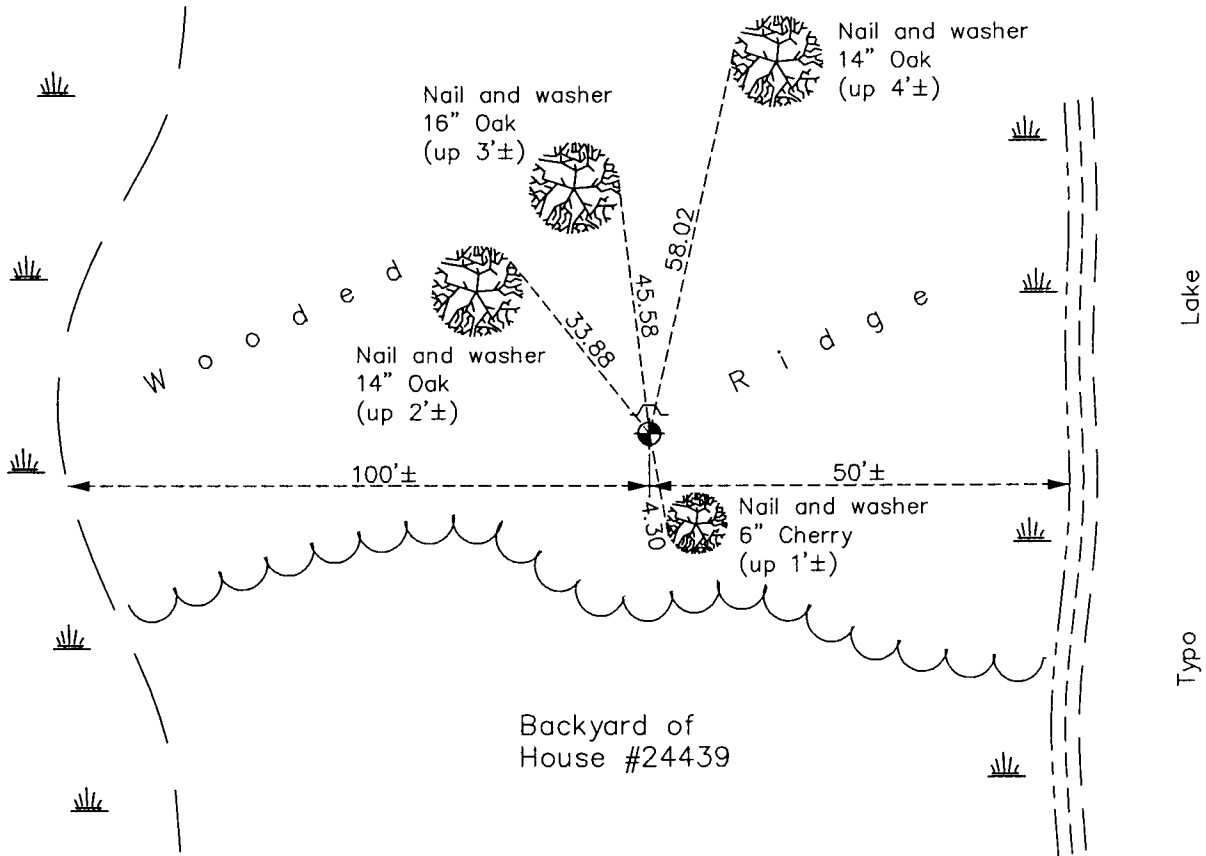

Revision Date

12/07/15

N.A.D. 1983 Coordinates
(1996 Adjustment)

County Project Coordinates	
Northing	237911.5119
Easting	544529.0008
Date	1/12/04

I hereby certify that this United States public land survey monument record is correct and complete to the best of my knowledge and belief.

Larry D. Hoium Date 12/07/15
 _____, Anoka County Surveyor
 Minnesota License Number 18165