

CERTIFICATE OF LOCATION OF GOVERNMENT CORNER

County of Anoka

State of Minnesota


North 1/4 Corner of Sec. 30 Township 34 Range 22

On the 1st day of February, 1979, the described corner was evidenced by area resurvey

and to perpetuate the location of said corner, at the exact location thereof, a permanent marker was placed consisting of a cast iron monument with a sign and post on the north side

AND on the 7th day of May, 2014, said permanent marker was found and the ties
were updated

Updated reference ties are as shown below.

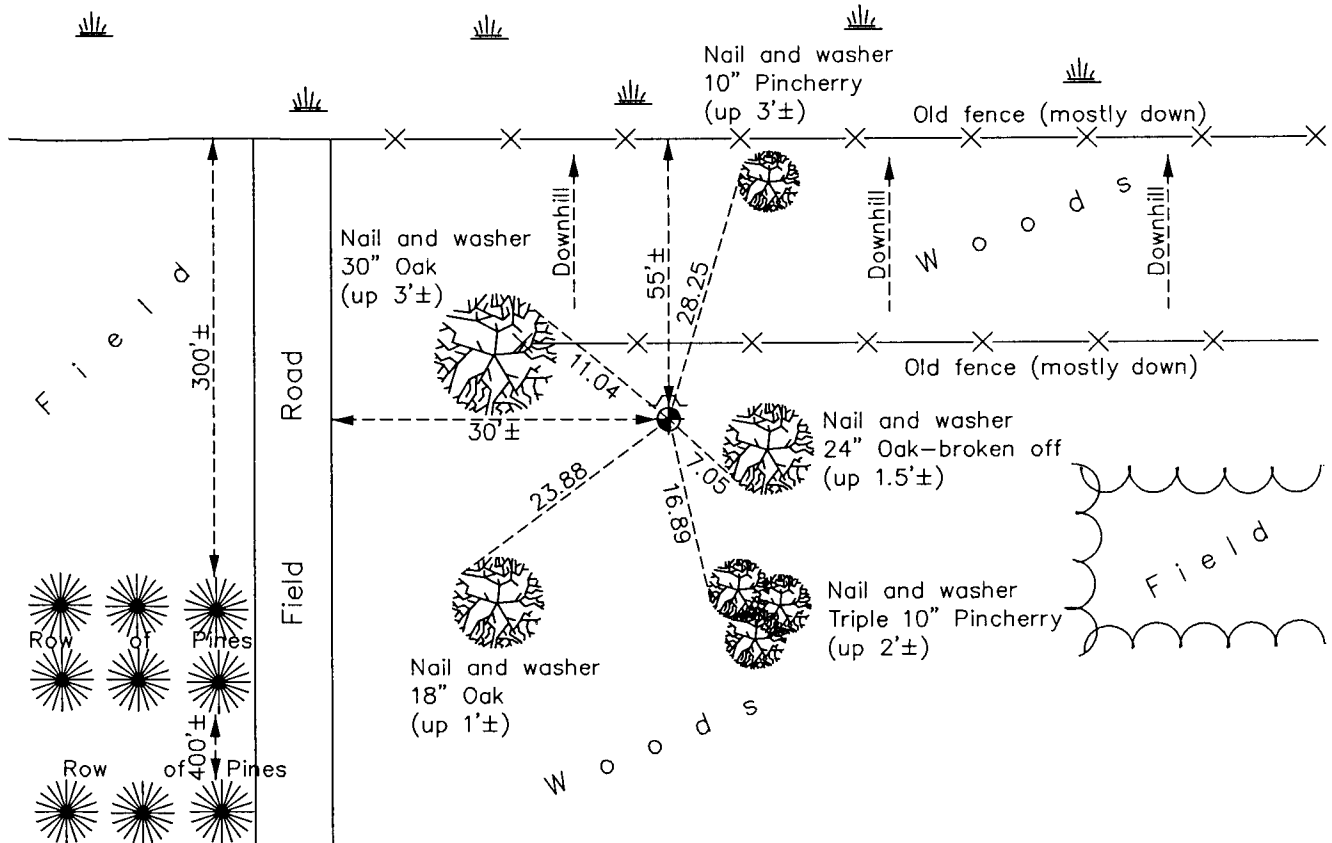

N

S

Revision Date

12/08/15

N.A.D. 1983 Coordinates
(1996 Adjustment)

County Project Coordinates	
Northing	<u>238022.2224</u>
Easting	<u>534301.1000</u>
Date	<u>5/03/04</u>

I hereby certify that this United States public land survey monument record is correct and complete to the best of my knowledge and belief.

Larry D. Hoium Date 12/08/15

 Larry D. Hoium, Anoka County Surveyor

Minnesota License Number 18165