

CERTIFICATE OF LOCATION OF GOVERNMENT CORNER

County of Anoka

State of Minnesota



West 1/4 Corner of Sec. 26 Township 34 Range 22

On the 4th day of February, 1963, the described corner was evidenced by a cast iron monument set by N.C. Hoium

and to perpetuate the location of said corner, at the exact location thereof, a permanent marker was placed consisting of the same cast iron monument with a sign and post on the north side

AND on the 29th day of January, 2014, said permanent marker was found with the sign missing and the ties were updated. The sign was replaced on August 18, 2014.

Updated reference ties are as shown below.

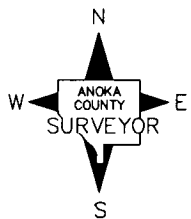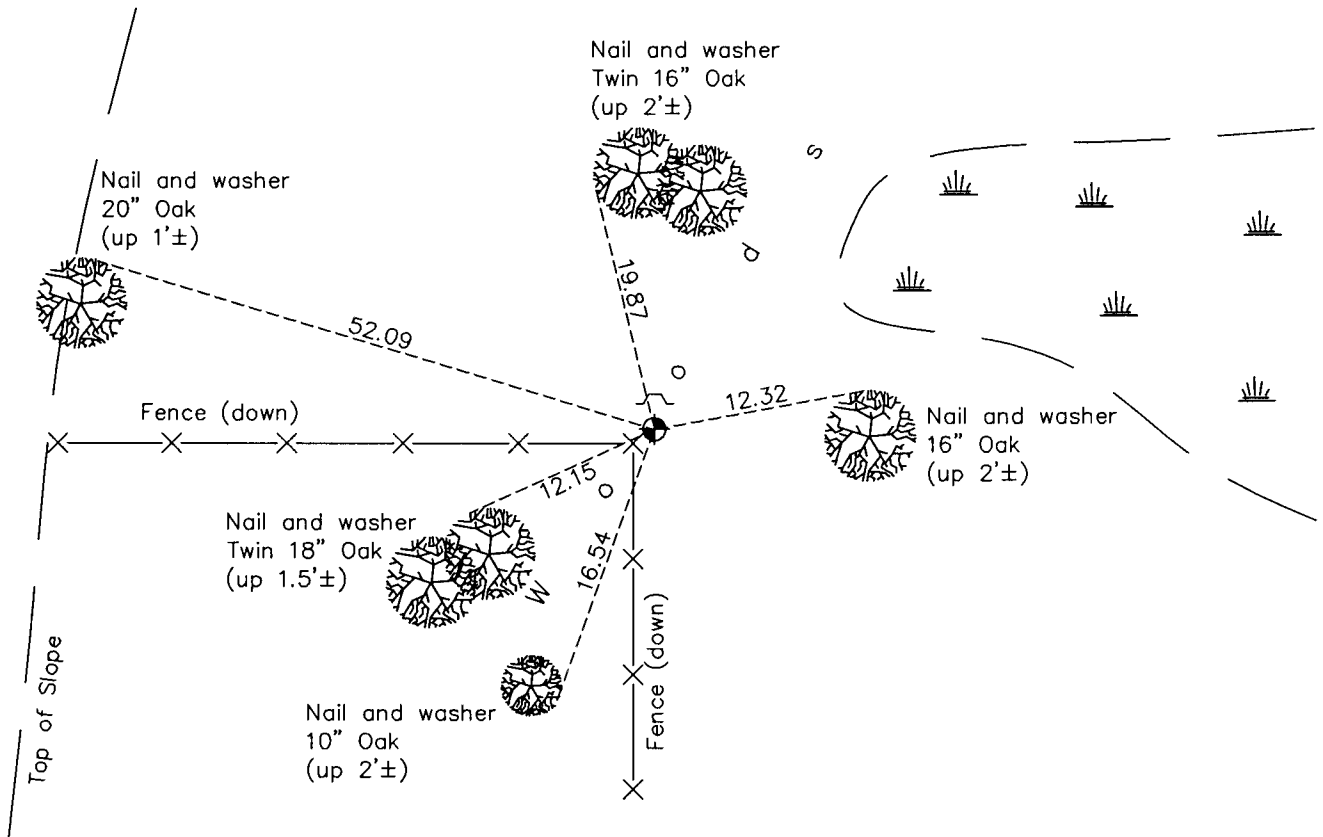

Revision Date
12/15/15

N.A.D. 1983 Coordinates
(1996 Adjustment)

County Project Coordinates	
Northing	234951.6365
Easting	552996.7554
Date	1/15/04

I hereby certify that this United States public land survey monument record is correct and complete to the best of my knowledge and belief.

Larry D. Hoium Date 12/15/15
 Larry D. Hoium, Anoka County Surveyor
 Minnesota License Number 18165