

# CERTIFICATE OF LOCATION OF GOVERNMENT CORNER

County of Anoka

State of Minnesota



## East 1/4 Corner of Sec. 25 Township 34 Range 22

On the 4th day of February, 1975, the described corner was evidenced by a cast iron monument

and to perpetuate the location of said corner, at the exact location thereof, a permanent marker was placed consisting of an aluminum disk marked "Chisago County Survey Marker" set by Chisago County Surveyor

AND on the 5th day of February, 2014, said permanent marker was found and the ties were updated

Updated reference ties are as shown below.

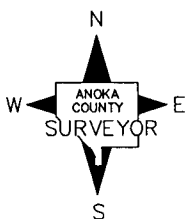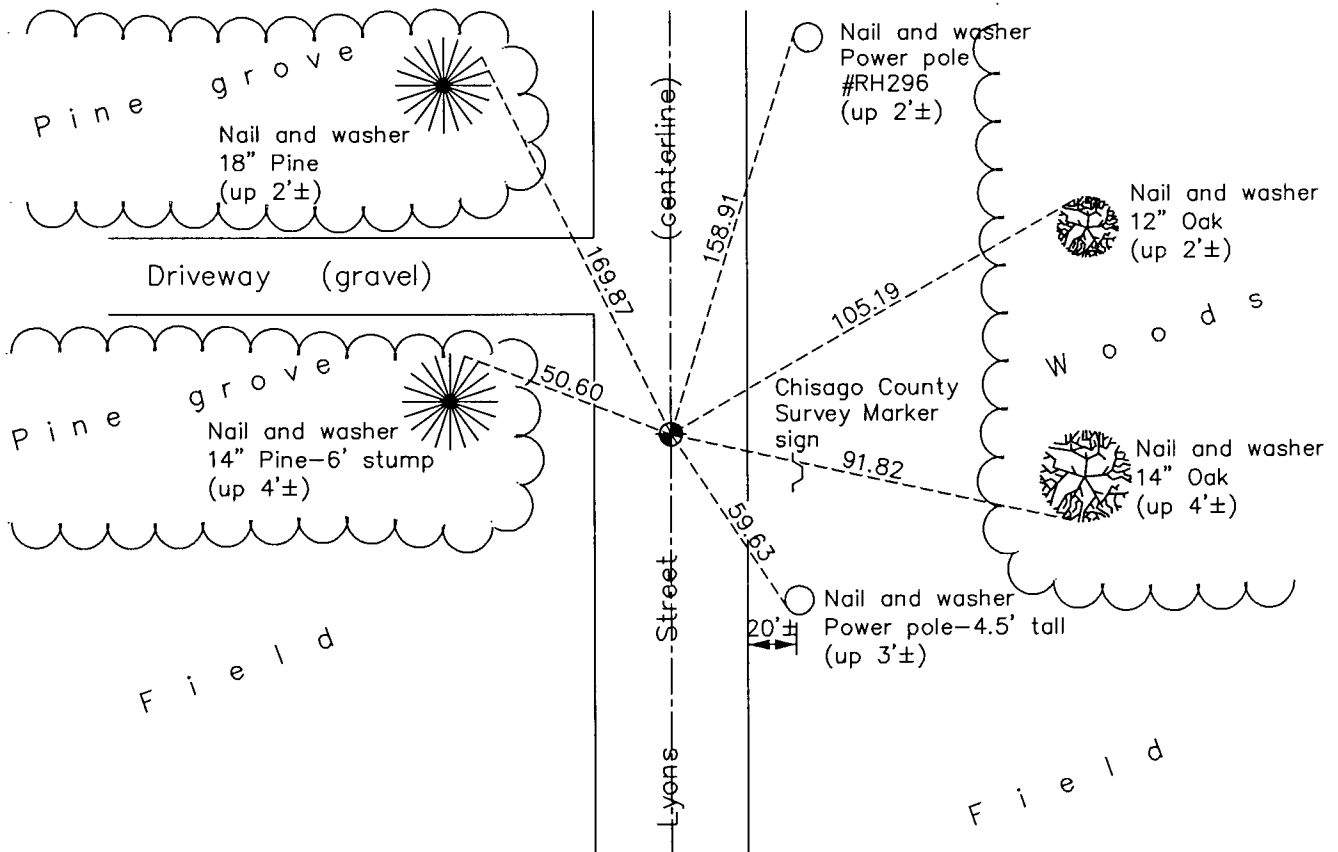

N.A.D. 1983 Coordinates  
(1996 Adjustment)

County Project Coordinates	
Northing	<u>234722.3338</u>
Easting	<u>563538.5806</u>
Date	<u>6/03/03</u>

Revision Date  
12/15/15

I hereby certify that this United States public land survey monument record is correct and complete to the best of my knowledge and belief.

*Larry D. Hoium* Date 12/15/15

Larry D. Hoium, Anoka County Surveyor  
Minnesota License Number 18165