

# CERTIFICATE OF LOCATION OF GOVERNMENT CORNER

County of Anoka

State of Minnesota


## South 1/4 Corner of Sec. 27 Township 34 Range 22

On the 16th day of March, 1967, the described corner was evidenced by area resurvey


and to perpetuate the location of said corner, at the exact location thereof, a permanent marker was placed consisting of a cast iron monument with a sign and post on the north side

AND on the 17th day of January, 2014, said permanent marker was found up 0.1'± and the ties were updated

Updated reference ties are as shown below.

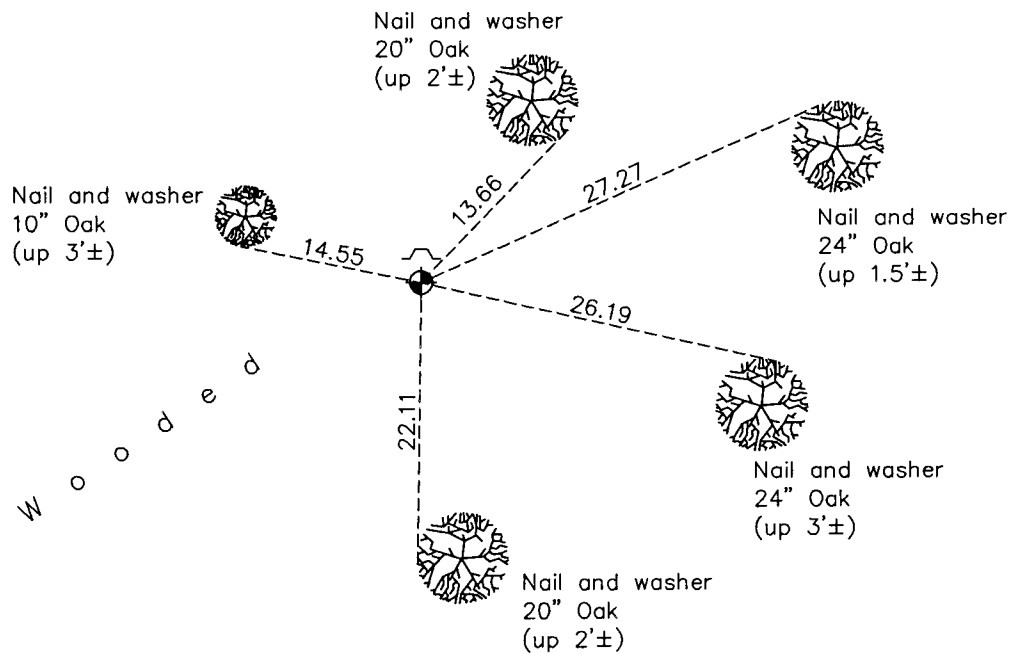

Town Road (gravel)

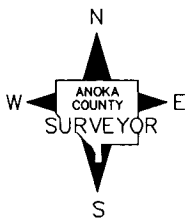

Revision Date

12/18/15

N.A.D. 1983 Coordinates  
(1996 Adjustment)

County Project Coordinates	
Northing	<u>232423.6387</u>
Easting	<u>550403.5261</u>
Date	<u>1/29/04</u>

I hereby certify that this United States public land survey monument record is correct and complete to the best of my knowledge and belief.

*Larry D. Hoium* Date 12/18/15

Larry D. Hoium, Anoka County Surveyor

Minnesota License Number 18165