

CERTIFICATE OF LOCATION OF GOVERNMENT CORNER

County of Anoka

State of Minnesota



West 1/4 Corner of Sec. 34 Township 34 Range 22

On the 2nd day of January, 1975, the described corner was evidenced by a 1" iron pipe

and to perpetuate the location of said corner, at the exact location thereof, a permanent marker was placed consisting of a red and white iron pipe

AND on the 12th day of February, 2014, said permanent marker was found up 3'± and the ties were updated

Updated reference ties are as shown below.

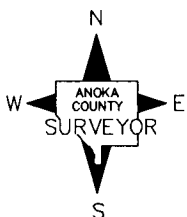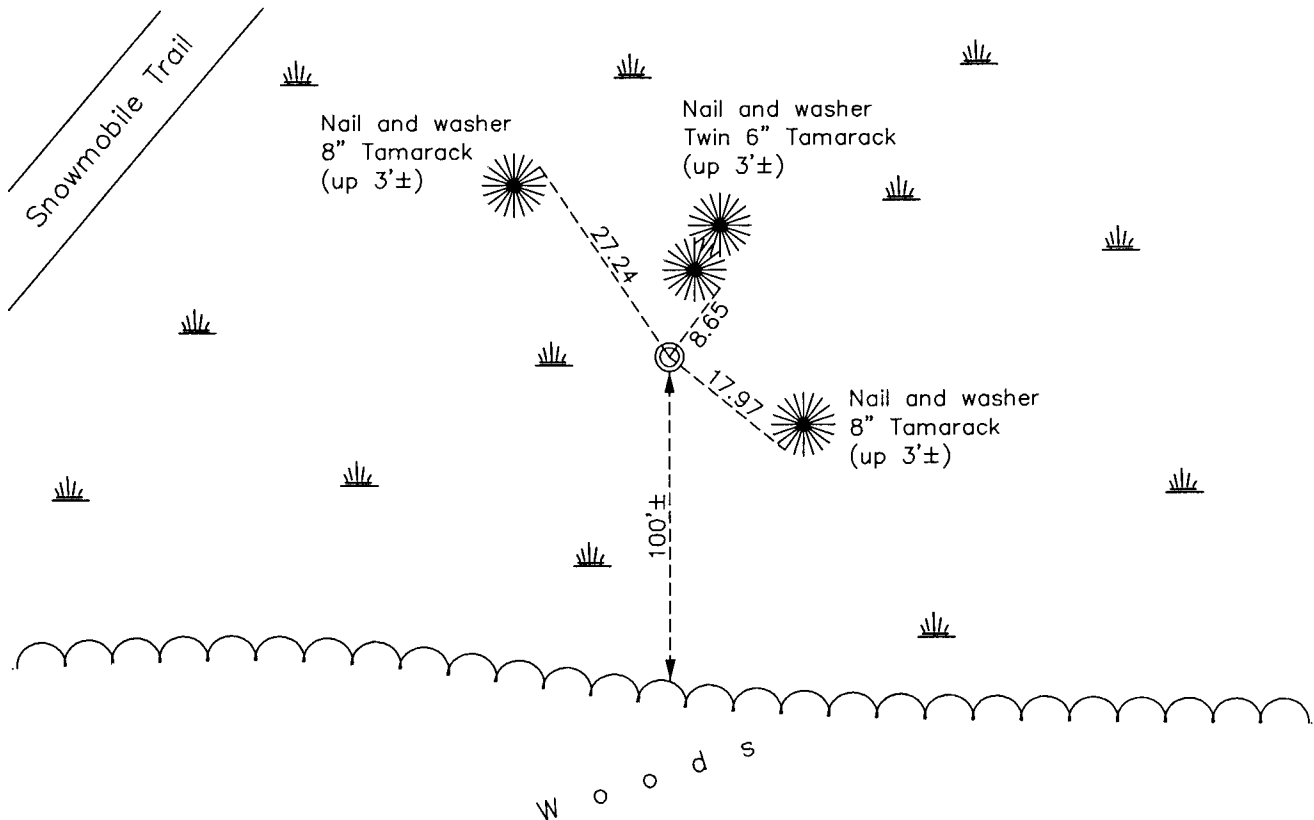

Revision Date
 12/24/15

N.A.D. 1983 Coordinates
 (1996 Adjustment)

County Project Coordinates	
Northing	<u>229872.2085</u>
Easting	<u>547784.9670</u>
Date	<u>2/12/04</u>

I hereby certify that this United States public land survey monument record is correct and complete to the best of my knowledge and belief.

Larry D. Hoium Date 12/24/15
 Larry D. Hoium, Anoka County Surveyor
 Minnesota License Number 18165