

# CERTIFICATE OF LOCATION OF GOVERNMENT CORNER

County of Anoka

State of Minnesota


Witness Corner of Sec. 36 Township 34 Range 22  
(on west line of SW 1/4)

On the 30th day of September, 1975, the described corner was evidenced by area resurvey

and to perpetuate the location of said corner, at the exact location thereof, a permanent marker was placed consisting of a cast iron monument with a sign and post on the north side


AND on the 4th day of February, 2014, said permanent marker was found and the ties were updated

Updated reference ties are as shown below.

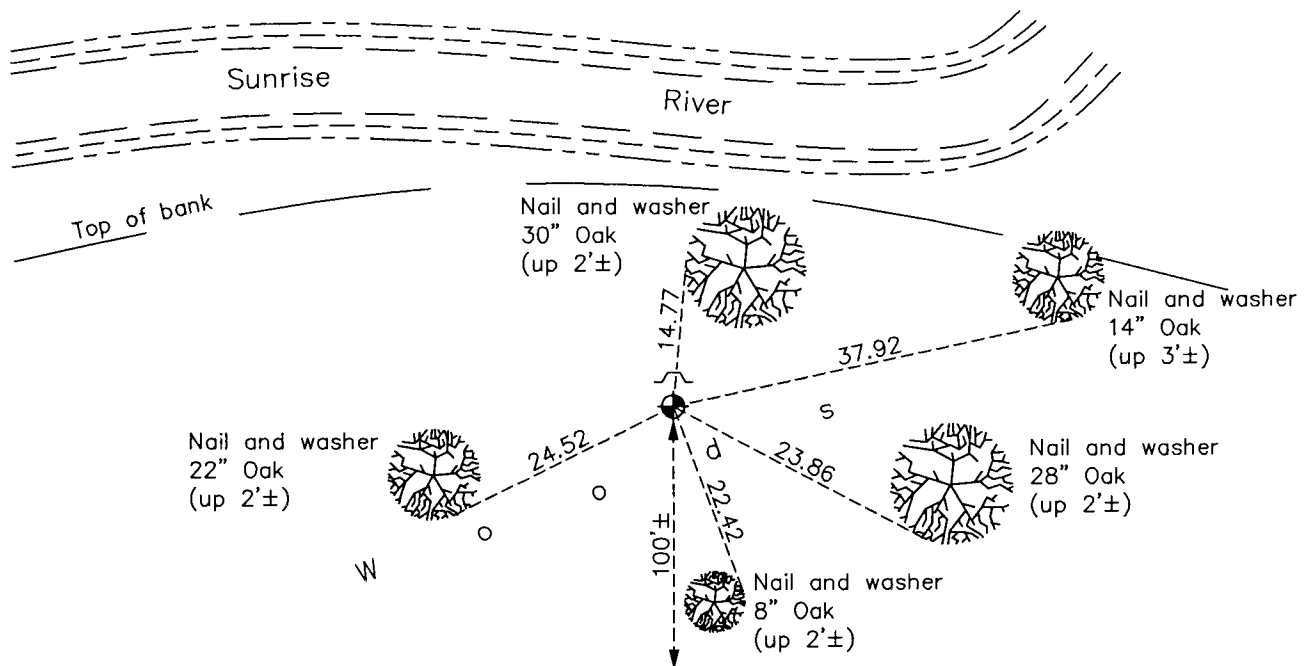

Road (blacktop)

County Road No. 77

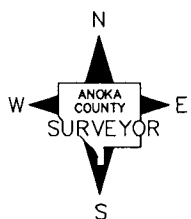

Revision Date  
12/24/15

N.A.D. 1983 Coordinates  
(1996 Adjustment)

County Project Coordinates	
Northing	229332.3392
Easting	558440.7638
Date	2/06/04

I hereby certify that this United States public land survey monument record is correct and complete to the best of my knowledge and belief.

*Larry D. Hoium* Date 12/24/15

Larry D. Hoium, Anoka County Surveyor

Minnesota License Number 18165