

CERTIFICATE OF LOCATION OF GOVERNMENT CORNER

County of Anoka

State of Minnesota


Witness Corner of Sec. 36 Township 34 Range 23
(on north line of NW 1/4)

On the 5th day of October, 1978, the described corner was evidenced by area resurvey

and to perpetuate the location of said corner, at the exact location thereof, a permanent marker was placed consisting of a cast iron monument with a sign and post on the north side

AND on the 24th day of April, 2012, said permanent marker was found with sign missing.
Sign was replaced and the ties were updated.

Updated reference ties are as shown below.

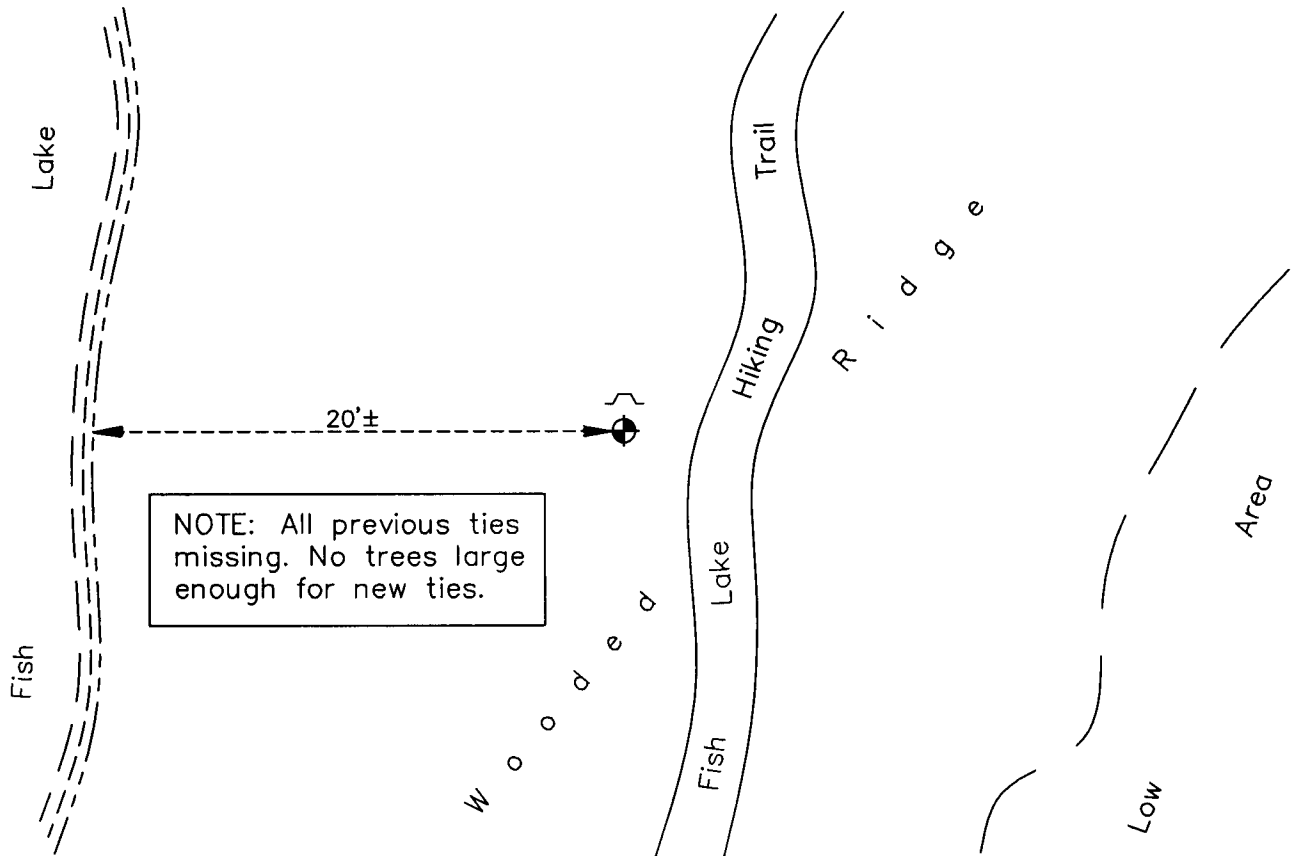

NOTE: All previous ties missing. No trees large enough for new ties.

N
W ANOKA COUNTY SURVEYOR E
S

Revision Date
3/20/13

N.A.D. 1983 Coordinates
(1996 Adjustment)

County Project Coordinates	
Northing	<u>232855.4866</u>
Easting	<u>527214.8168</u>
Date	<u>4/07/03</u>

I hereby certify that this United States public land survey monument record is correct and complete to the best of my knowledge and belief.

Larry D. Hoium Date 3/20/13
 Larry D. Hoium, Anoka County Surveyor
 Minnesota License Number 18165