

# CERTIFICATE OF LOCATION OF GOVERNMENT CORNER

County of Anoka

State of Minnesota



Witness Corner of Sec. 35 Township 34 Range 23  
(on north line of section)

On the 9th day of December, 1976, the described corner was evidenced by a 1" iron pipe

and to perpetuate the location of said corner, at the exact location thereof, a permanent marker was placed consisting of a cast iron monument with a sign and post on the north side

AND on the 27th day of September, 2012, said permanent marker was found and the ties were updated

Updated reference ties are as shown below.

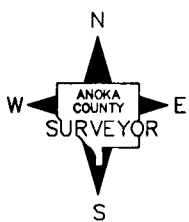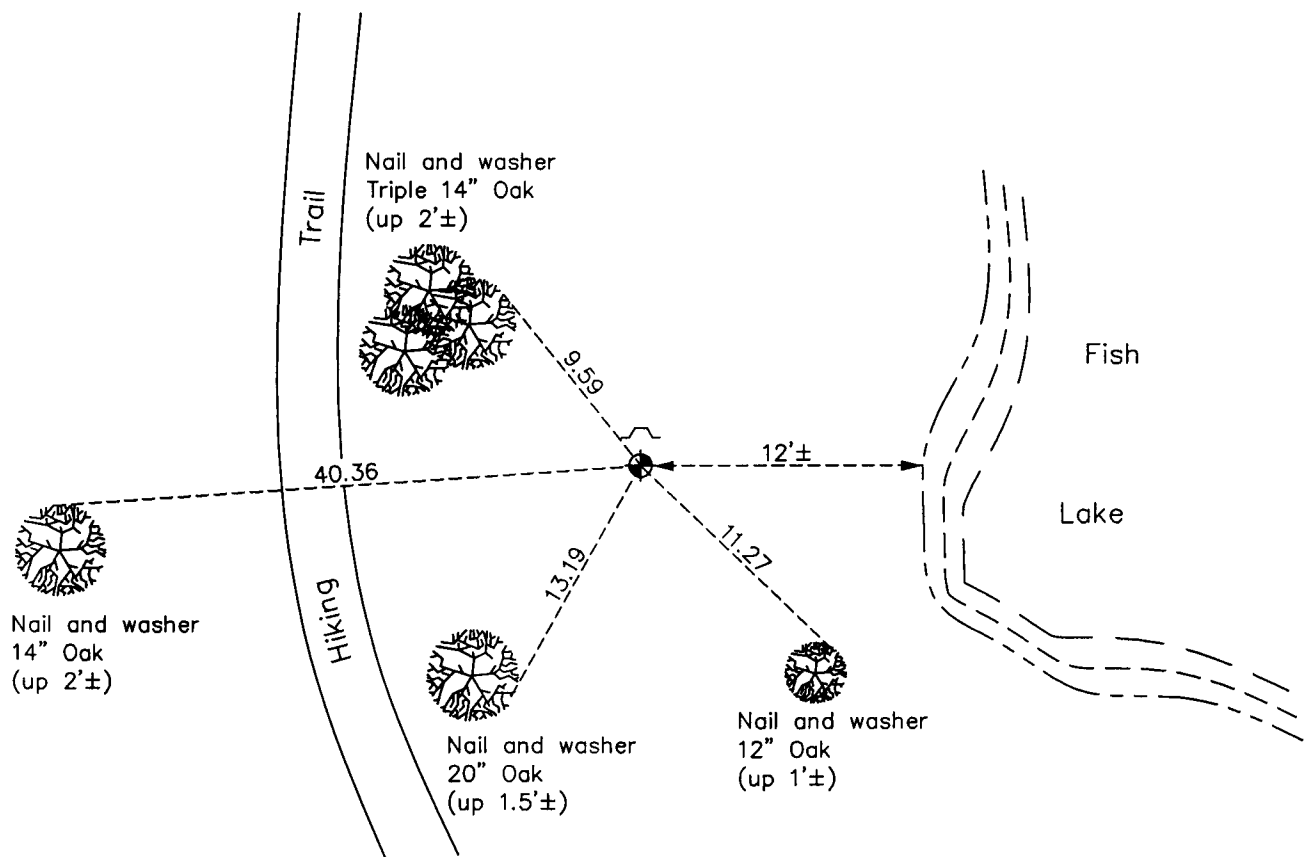

Revision Date

3/20/13

N.A.D. 1983 Coordinates  
(1996 Adjustment)

County Project Coordinates	
Northing	232870.6989
Easting	523671.8758
Date	4/09/03

I hereby certify that this United States public land survey monument record is correct and complete to the best of my knowledge and belief.

*Larry D. Hoium* Date 3/20/13

Larry D. Hoium, Anoka County Surveyor

Minnesota License Number 18165