

CERTIFICATE OF LOCATION OF GOVERNMENT CORNER

County of Anoka

State of Minnesota



Witness Corner of Sec. 32 Township 34 Range 23
(to N 1/4 corner of section)

On the 31st day of May, 1960, the described corner was evidenced by a chisel mark

and to perpetuate the location of said corner, at the exact location thereof, a permanent marker was placed consisting of a 1/2" iron pipe set using ties

AND on the 20th day of December, 2012, said permanent marker was under bituminous and was not uncovered

Updated reference ties are as shown below.

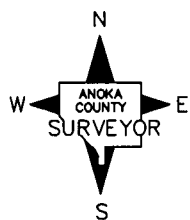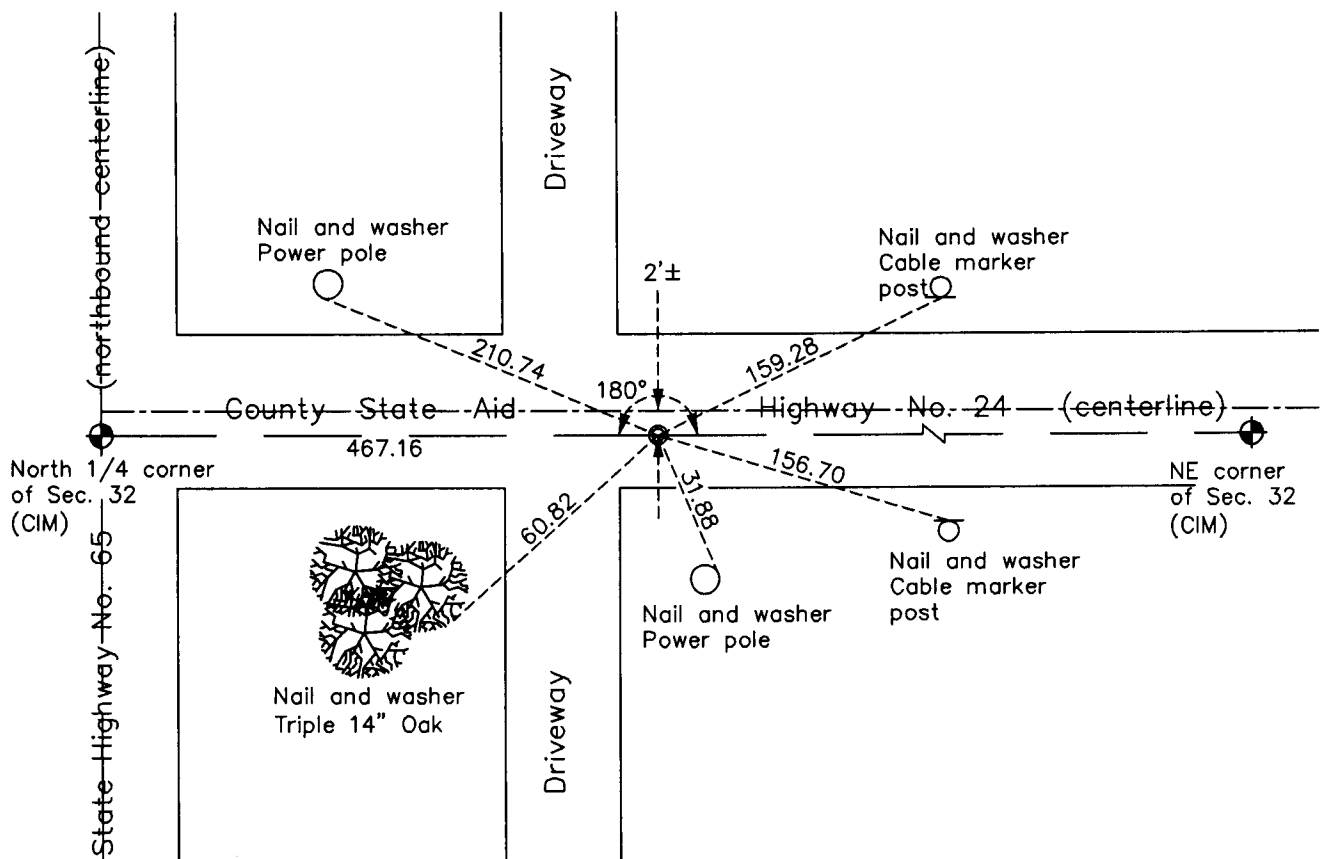

Revision Date

11/26/13

N.A.D. 1983 Coordinates
(1996 Adjustment)

County Project Coordinates

Northing 232731.0974

Easting 508683.6557

Date 5/09/02

I hereby certify that this United States public land survey monument record is correct and complete to the best of my knowledge and belief.

Larry D. Hoium Date 11/26/13

Larry D. Hoium, Anoka County Surveyor

Minnesota License Number 18165