

CERTIFICATE OF LOCATION OF GOVERNMENT CORNER

County of Anoka

State of Minnesota



Witness Corner of Sec. 36 Township 34 Range 23
 (on west line of NW 1/4)

On the 5th day of October, 1978, the described corner was evidenced by area resurvey

and to perpetuate the location of said corner, at the exact location thereof, a permanent marker was placed consisting of a cast iron monument

AND on the 24th day of April, 2012, said permanent marker was found with a sign and post on the north side and the ties were updated

Updated reference ties are as shown below.

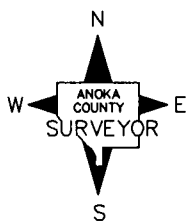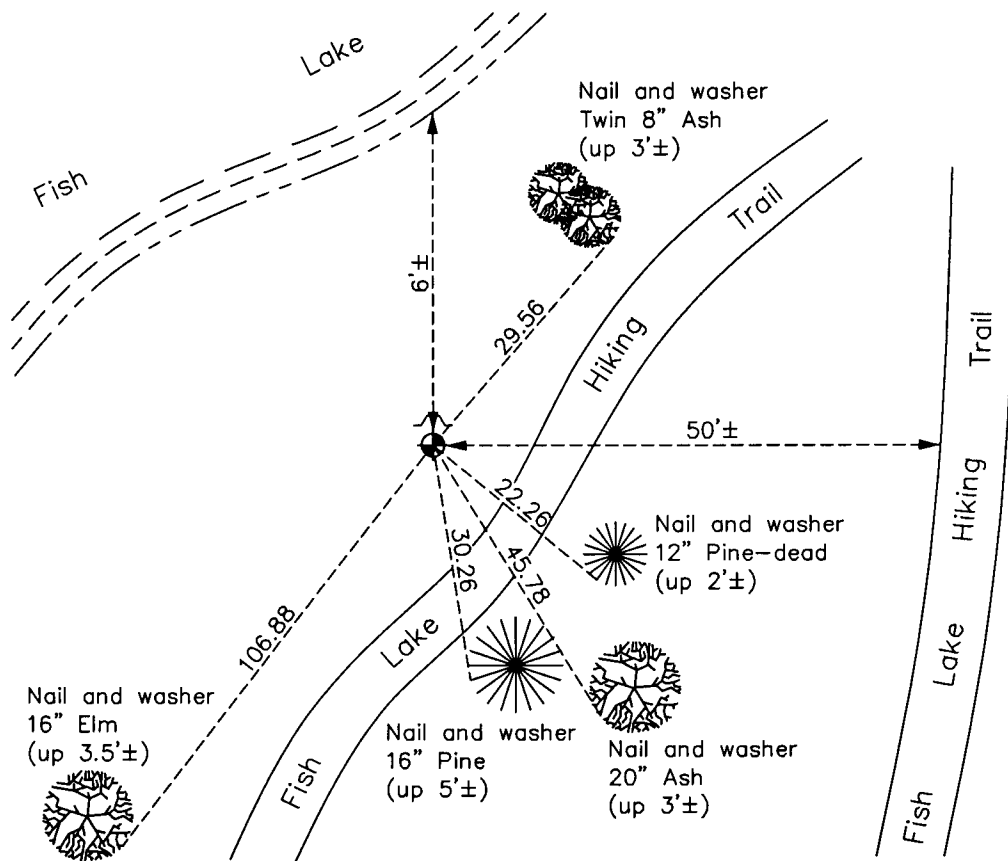

Revision Date
3/28/13

N.A.D. 1983 Coordinates
 (1996 Adjustment)

County Project Coordinates	
Northing	<u>232277.8956</u>
Easting	<u>526621.0034</u>
Date	<u>4/07/03</u>

I hereby certify that this United States public land survey monument record is correct and complete to the best of my knowledge and belief.

Larry D. Hoium Date 3/28/13

Larry D. Hoium, Anoka County Surveyor
 Minnesota License Number 18165