

CERTIFICATE OF LOCATION OF GOVERNMENT CORNER

County of Anoka

State of Minnesota

Meander Corner of Sec. 1 Township 30 Range 24


(on west side of Laddie Lake)

On the 27th day of June, 1960, the described corner was evidenced by a concrete monument

and to perpetuate the location of said corner, at the exact location thereof, a permanent marker was placed consisting of a cast iron monument with a sign and post on the south side

AND on the 21st day of November, 2014, said permanent marker was found and the ties were updated

Updated reference ties are as shown below.

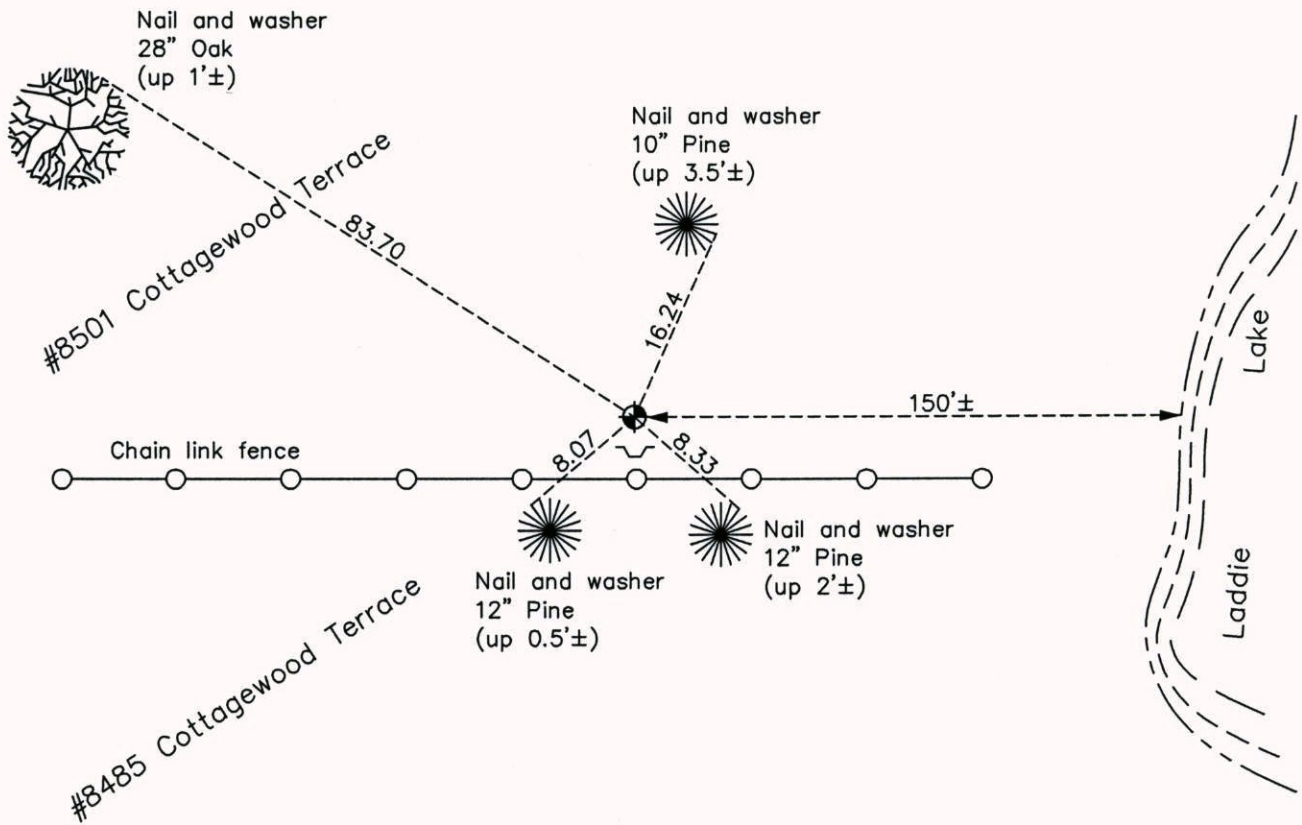

Revision Date
3/13/15

N.A.D. 1983 Coordinates
(1996 Adjustment)

County Project Coordinates	
Northing	<u>132550.2298</u>
Easting	<u>505946.4223</u>
Date	<u>N/A</u>

I hereby certify that this United States public land survey monument record is correct and complete to the best of my knowledge and belief.

Larry D. Hoium Date 3/13/15

Larry D. Hoium, Anoka County Surveyor

Minnesota License Number 18165