

# CERTIFICATE OF LOCATION OF GOVERNMENT CORNER

County of Anoka

State of Minnesota


## Northwest Corner of Sec. 1 Township 30 Range 24

On the 21st day of June, 1960, the described corner was evidenced by a concrete monument set by Harvey Cartwright

and to perpetuate the location of said corner, at the exact location thereof, a permanent marker was placed consisting of a cast iron monument set on top of the concrete monument

AND on the 17th day of November, 2014, said permanent marker was found down 0.3'± and the ties were updated

Updated reference ties are as shown below.

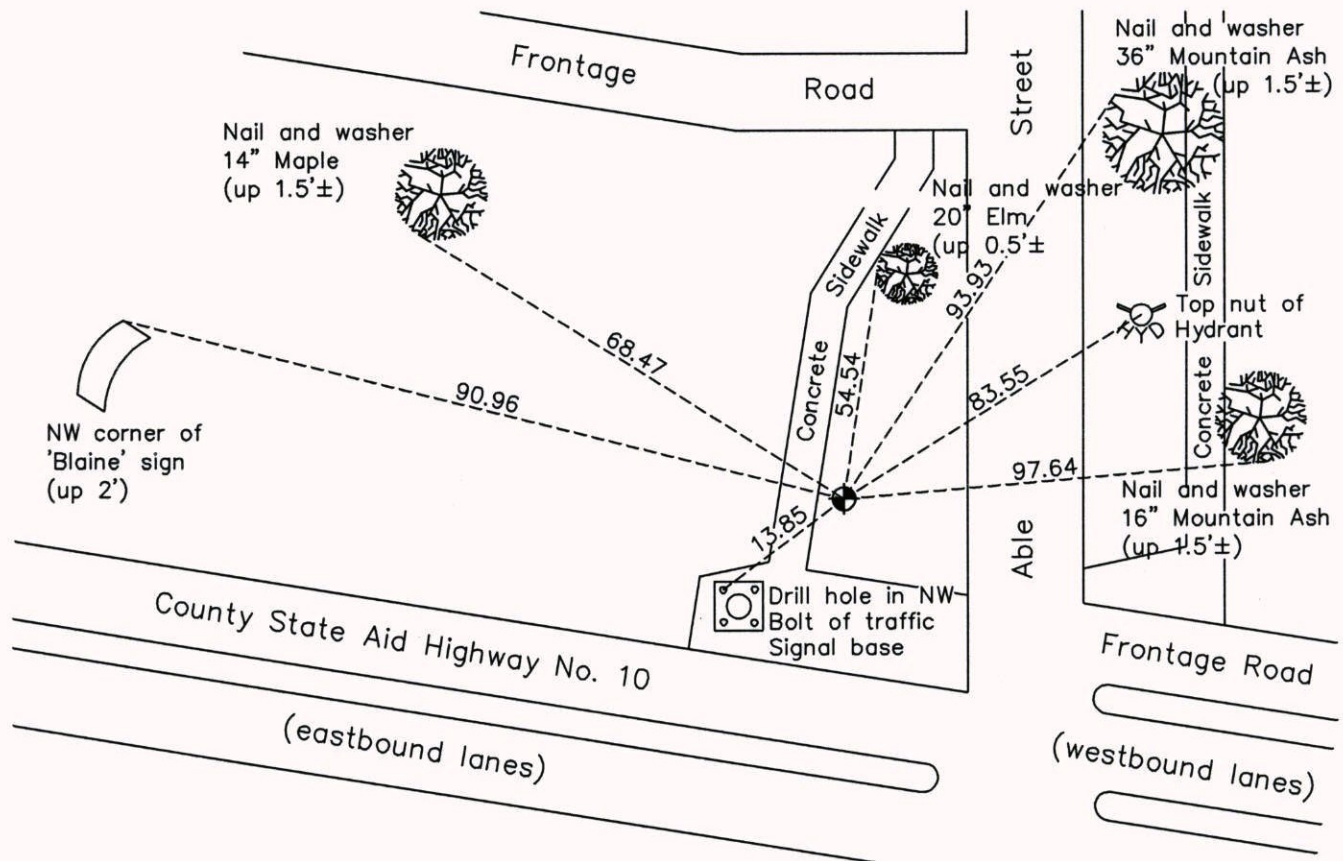

N

W ANOKA COUNTY SURVEYOR E

S

Revision Date

3/13/15

N.A.D. 1983 Coordinates  
(1996 Adjustment)

County Project Coordinates	
Northing	132544.0385
Easting	504688.5620
Date	8/13/03

I hereby certify that this United States public land survey monument record is correct and complete to the best of my knowledge and belief.

*Larry D. Hoium* Date 3/13/15

Larry D. Hoium, Anoka County Surveyor

Minnesota License Number 18165