

CERTIFICATE OF LOCATION OF GOVERNMENT CORNER

County of Anoka

State of Minnesota


East 1/4 Corner of Sec. 3 Township 30 Range 24

On the 14th day of May, 1964, the described corner was evidenced by a concrete monument

and to perpetuate the location of said corner, at the exact location thereof, a permanent marker was placed consisting of a cast iron monument

AND on the 31st day of March, 2015, said permanent marker was found broken and leaning westerly 0.2'±. Replaced with new cast iron monument and updated ties.

Updated reference ties are as shown below.

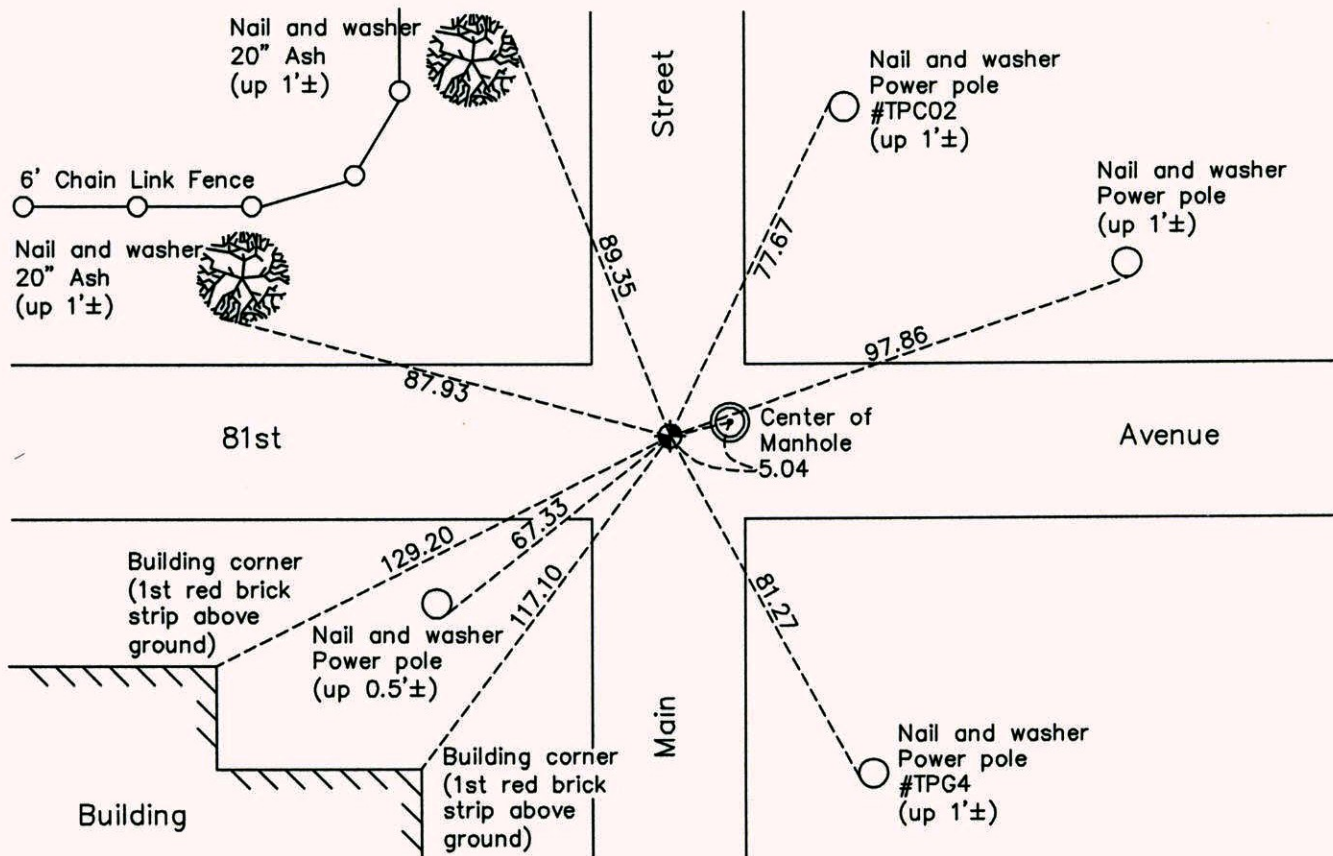

N
W ANOKA COUNTY SURVEYOR E
S

Revision Date
4/06/15

N.A.D. 1983 Coordinates
(1996 Adjustment)

County Project Coordinates	
Northing	129141.9321
Easting	499419.4916
Date	7/01/04

I hereby certify that this United States public land survey monument record is correct and complete to the best of my knowledge and belief.

Larry D. Hoium Date 4/06/15

Larry D. Hoium, Anoka County Surveyor
Minnesota License Number 18165