

# CERTIFICATE OF LOCATION OF GOVERNMENT CORNER

County of Anoka


State of Minnesota

CENTER Corner of Sec. 2 Township 30 Range 24

I hereby certify that on the 24<sup>TH</sup> day of July, 1964, I found the described corner which was evidenced by 1/2" IRON PIPE

and I further certify that to perpetuate the location of said corner, I did, at the exact location thereof, place a permanent marker consisting of 1/2" IRON PIPE

which reference or witness monuments are located in the manner following:

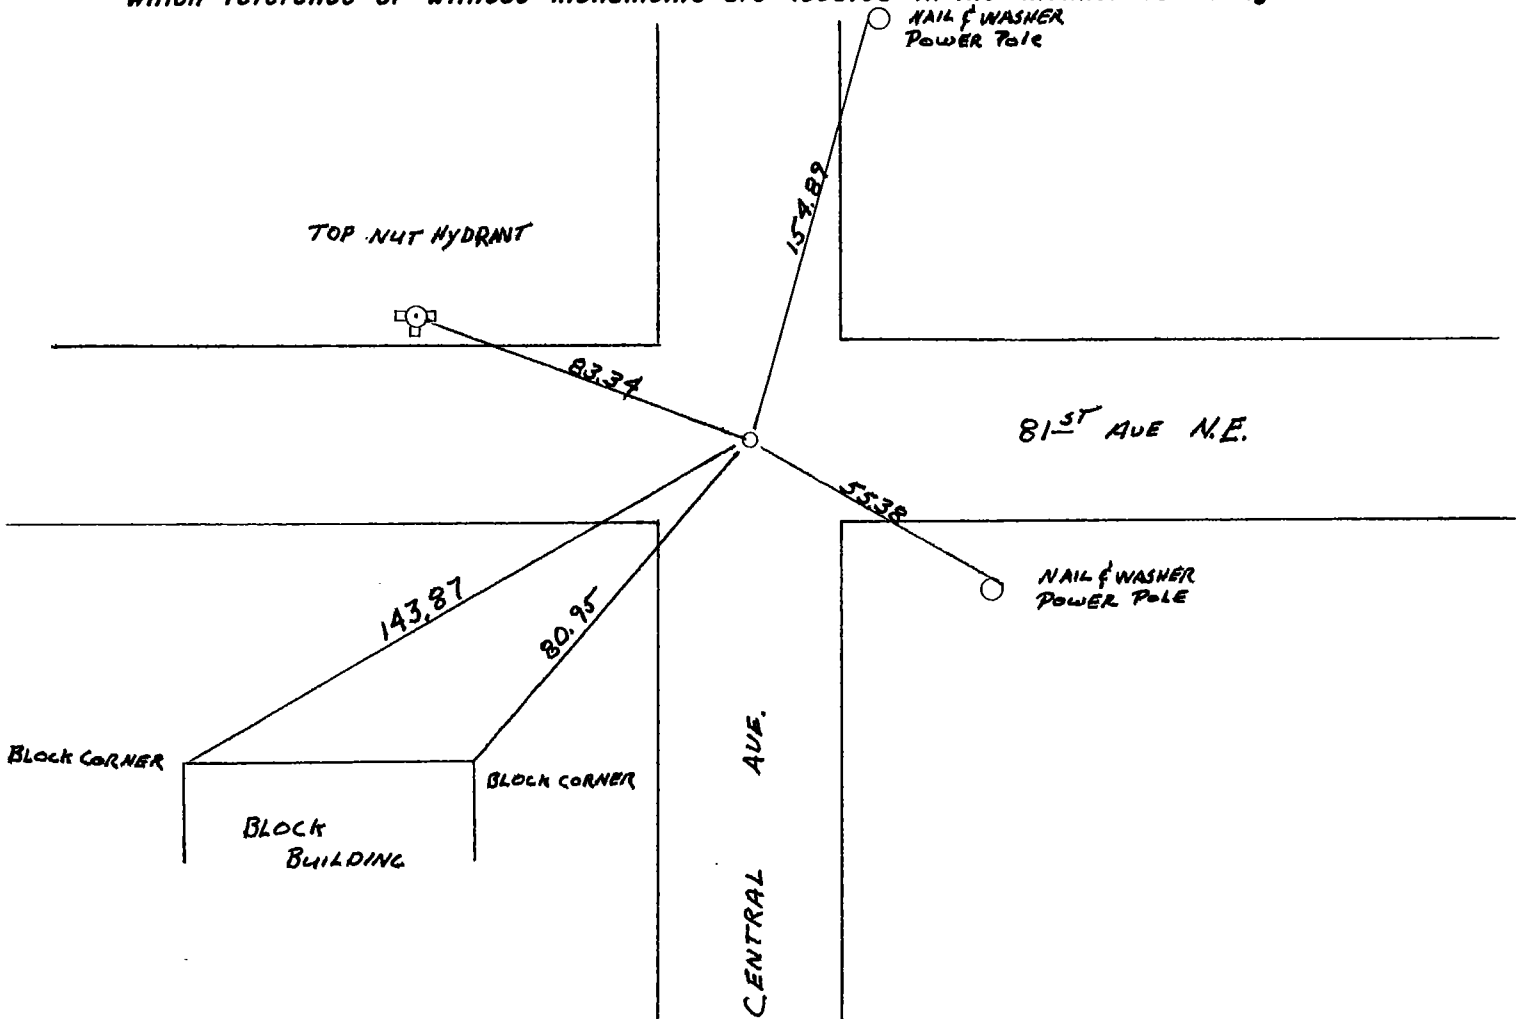

Revised date	Revised date	Revised date
6-24-74		
7-28-77		
7-11-80		
6-24-86		
7-24-89		

