

CERTIFICATE OF LOCATION OF GOVERNMENT CORNER

County of Anoka

State of Minnesota


Meander Corner of Sec. 1 Township 30 Range 24 (on east line of section)

On the 19th day of May, 1961, the described corner was evidenced by a granite monument

and to perpetuate the location of said corner, at the exact location thereof, a permanent marker was placed consisting of the same granite monument with an 'Anoka County' cap in the center

AND on the 13th day of November, 2014, said permanent marker was found down 0.5'± and the ties were updated

Updated reference ties are as shown below.

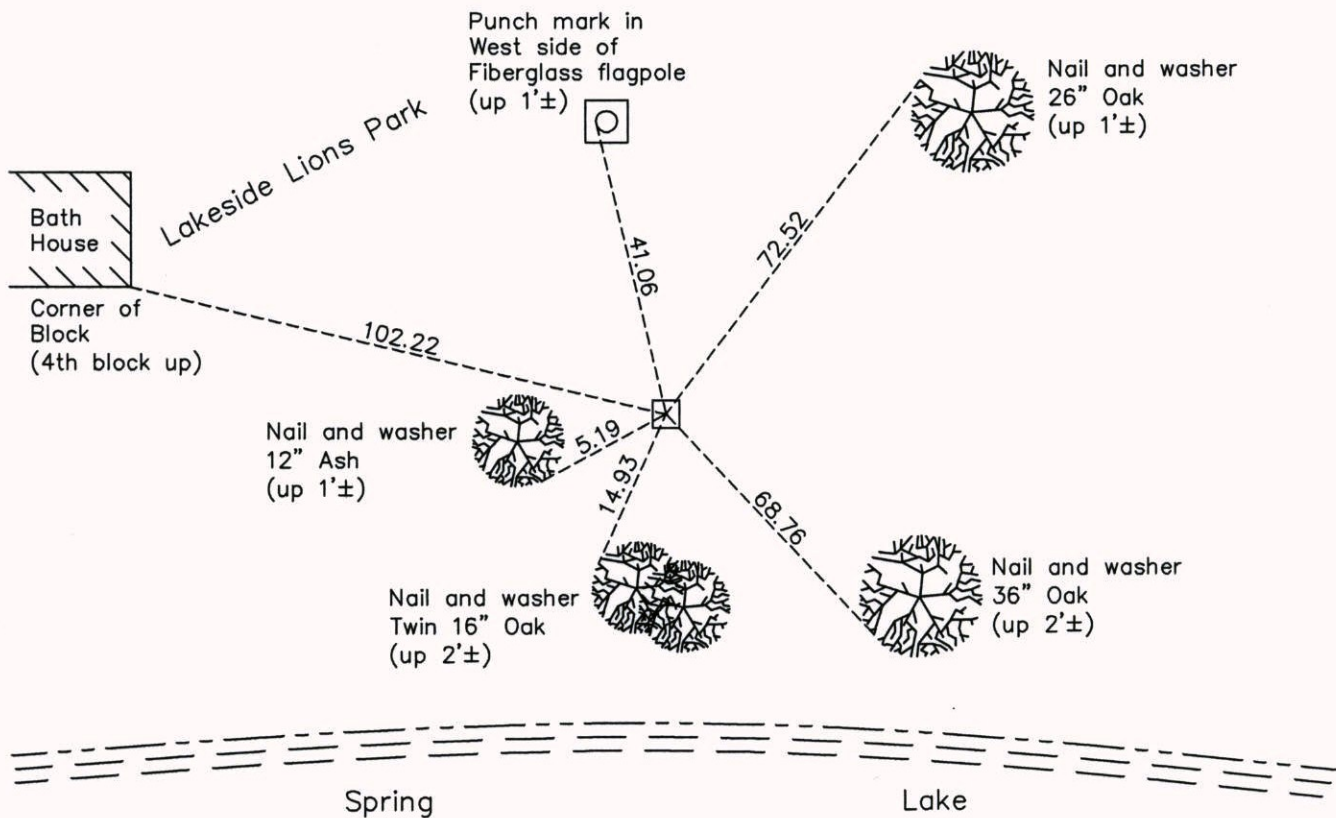

N
W ANOKA COUNTY SURVEYOR E
S

Revision Date
3/17/15

N.A.D. 1983 Coordinates
(1996 Adjustment)

County Project Coordinates	
Northing	127355.6103
Easting	510031.8003
Date	11/18/03

I hereby certify that this United States public land survey monument record is correct and complete to the best of my knowledge and belief.

Larry D. Hoium Date 3/17/15
 Larry D. Hoium, Anoka County Surveyor
 Minnesota License Number 18165