

# CERTIFICATE OF LOCATION OF GOVERNMENT CORNER

County of Anoka

State of Minnesota


Witness Corner of Sec. 10 Township 30 Range 24  
 (on north line of section)

On the 13th day of December, 1982, the described corner was evidenced by area resurvey

and to perpetuate the location of said corner, at the exact location thereof, a permanent marker was placed consisting of a cast iron monument

AND on the 2nd day of April, 2015, said permanent marker was found replaced with a P.K.nail. Replaced P.K. nail with a cast iron monument set down 0.05'± and the ties were updated.

Updated reference ties are as shown below.

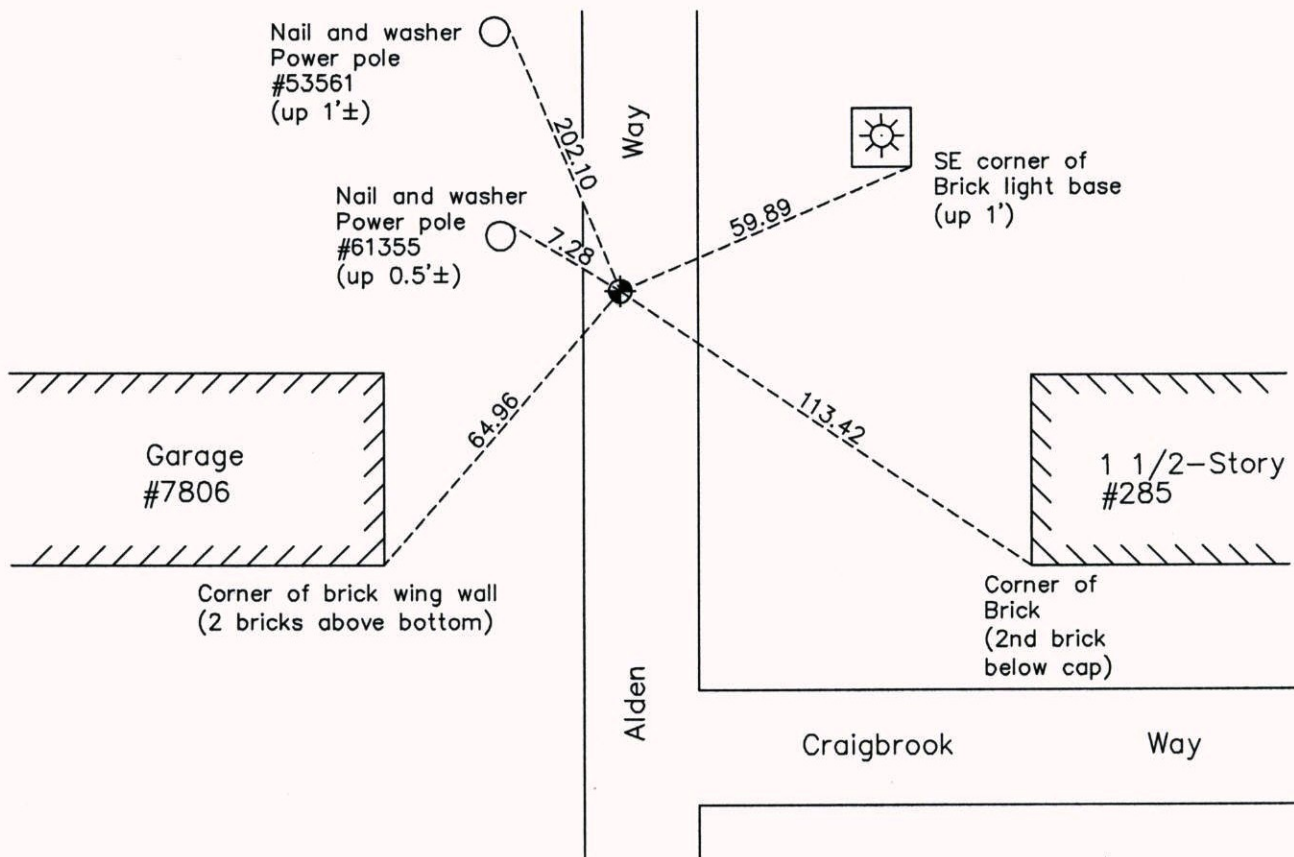

Revision Date

4/14/15

N.A.D. 1983 Coordinates  
(1996 Adjustment)

County Project Coordinates

Northing 126441.5149

Easting 496670.4260

Date 8/19/03

I hereby certify that this United States public land survey monument record is correct and complete to the best of my knowledge and belief.

*Larry D. Hoium* Date 4/14/15

Larry D. Hoium, Anoka County Surveyor

Minnesota License Number 18165