

CERTIFICATE OF LOCATION OF GOVERNMENT CORNER

County of Anoka

State of Minnesota


Witness Corner of Sec. 12 Township 30 Range 24
 (on east line of section)

On the 12th day of September, 1960, the described corner was evidenced by a granite
monument

and to perpetuate the location of said corner, at the exact location thereof, a permanent marker
 was placed consisting of a cast iron monument with a sign and post on the north side

AND on the 12th day of November, 2014, said permanent marker was found and the ties
were updated

Updated reference ties are as shown below.

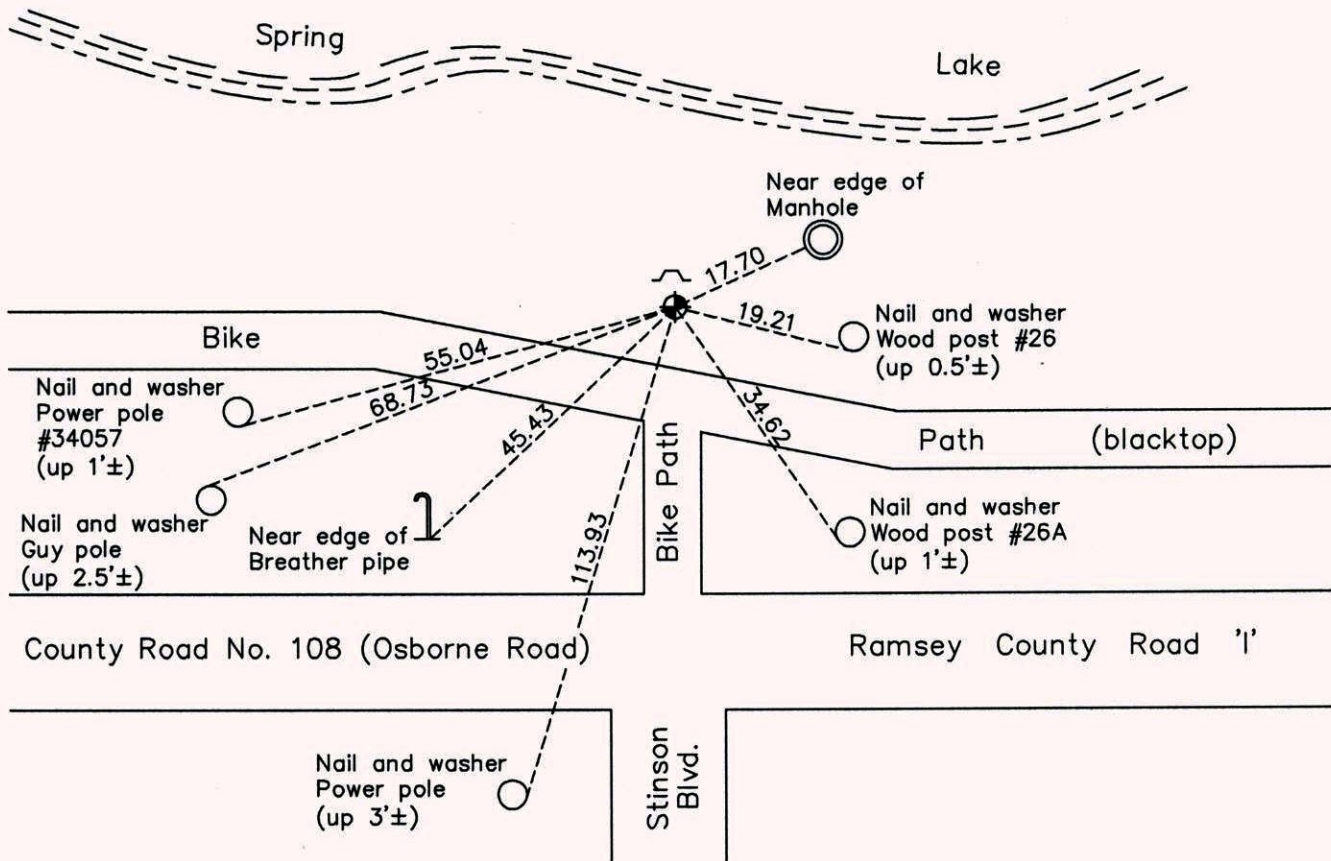

N

S

Revision Date

3/23/15

N.A.D. 1983 Coordinates
(1996 Adjustment)

County Project Coordinates	
Northing	126235.5761
Easting	510033.0107
Date	7/22/03

I hereby certify that this United States public land survey monument record is correct and complete to the best of my knowledge and belief.

Date 3/23/15

Larry D. Hoium, Anoka County Surveyor
 Minnesota License Number 18165