

CERTIFICATE OF LOCATION OF GOVERNMENT CORNER

County of Anoka

State of Minnesota

Meander Corner of Sec. 15 Township 30 Range 24


(on north line of section)

On the 18th day of May, 1961, the described corner was evidenced by a 4"X4"
concrete monument

and to perpetuate the location of said corner, at the exact location thereof, a permanent marker
was placed consisting of a cast iron monument with a sign and post on the north side

AND on the 6th day of November, 2014, said permanent marker was found and the ties
were updated

Updated reference ties are as shown below.

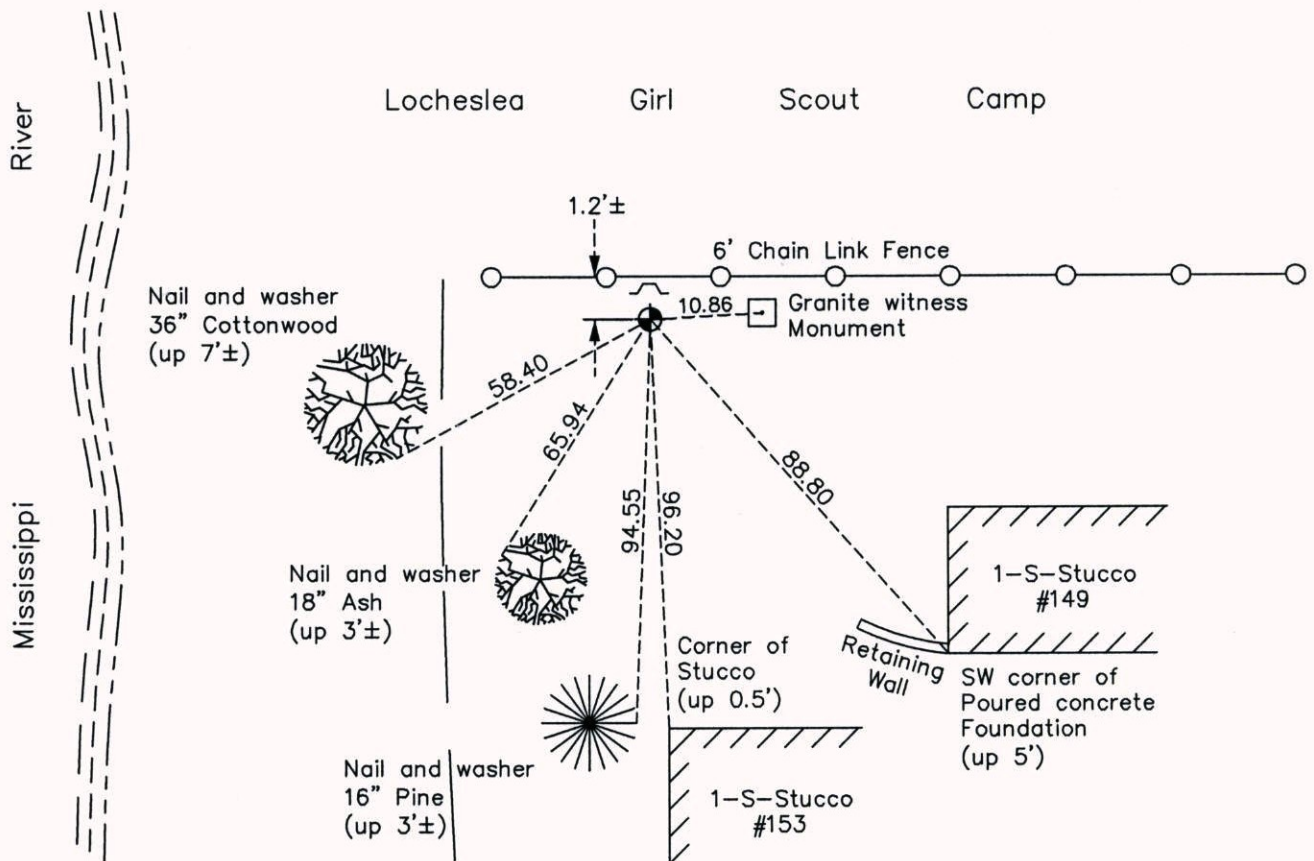

Revision Date
3/25/15

N.A.D. 1983 Coordinates
(1996 Adjustment)

County Project Coordinates	
Northing	121196.9758
Easting	497054.3364
Date	12/28/04

I hereby certify that this United States public land survey monument record is correct and complete to the best of my knowledge and belief.

Larry D. Hoium Date 3/25/15

Larry D. Hoium, Anoka County Surveyor
Minnesota License Number 18165