

CERTIFICATE OF LOCATION OF GOVERNMENT CORNER

County of Anoka

State of Minnesota


Northeast Corner of Sec. 24 Township 30 Range 24

On the 8th day of August, 1962, the described corner was evidenced by a granite monument

and to perpetuate the location of said corner, at the exact location thereof, a permanent marker was placed consisting of a cast iron monument

AND on the 29th day of October, 2014, said permanent marker was found to be a Ramsey County cast iron monument down 1'± in a covered tube and the ties were updated

Updated reference ties are as shown below.

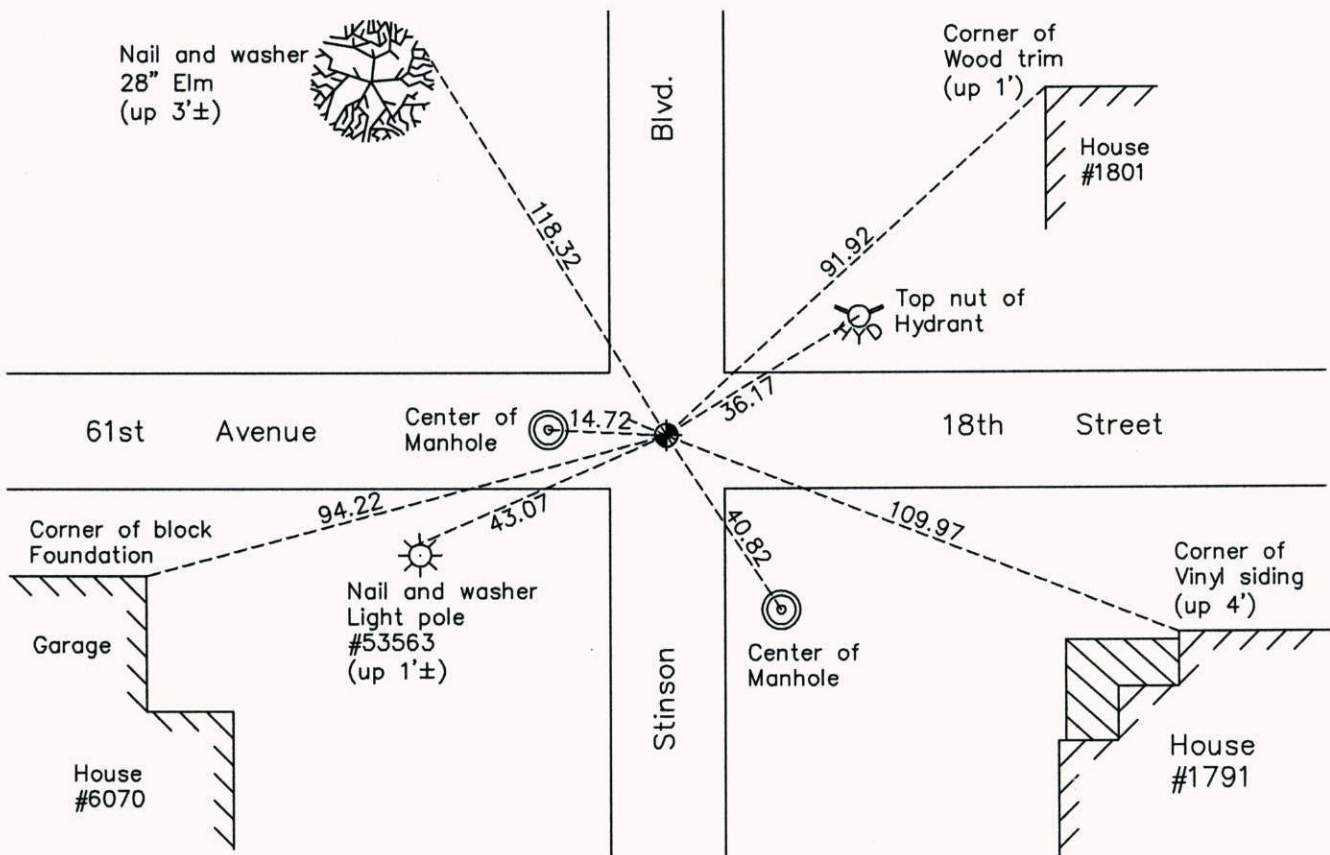

Revision Date
3/25/15

N.A.D. 1983 Coordinates
(1996 Adjustment)

County Project Coordinates	
Northing	115846.1810
Easting	510118.5742
Date	7/01/04

I hereby certify that this United States public land survey monument record is correct and complete to the best of my knowledge and belief.

Larry D. Hoium Date 3/25/15

Larry D. Hoium, Anoka County Surveyor
Minnesota License Number 18165