

# CERTIFICATE OF LOCATION OF GOVERNMENT CORNER

County of Anoka


State of Minnesota

CENTER Corner of Sec. 24 Township 30 Range 24

I hereby certify that on the 29 day of JULY, 1964, I found the described corner which was evidenced by 1/2" IRON PIPE

and I further certify that to perpetuate the location of said corner, I did, at the exact location thereof, place a permanent marker consisting of SAME

which reference or witness monuments are located in the manner following:

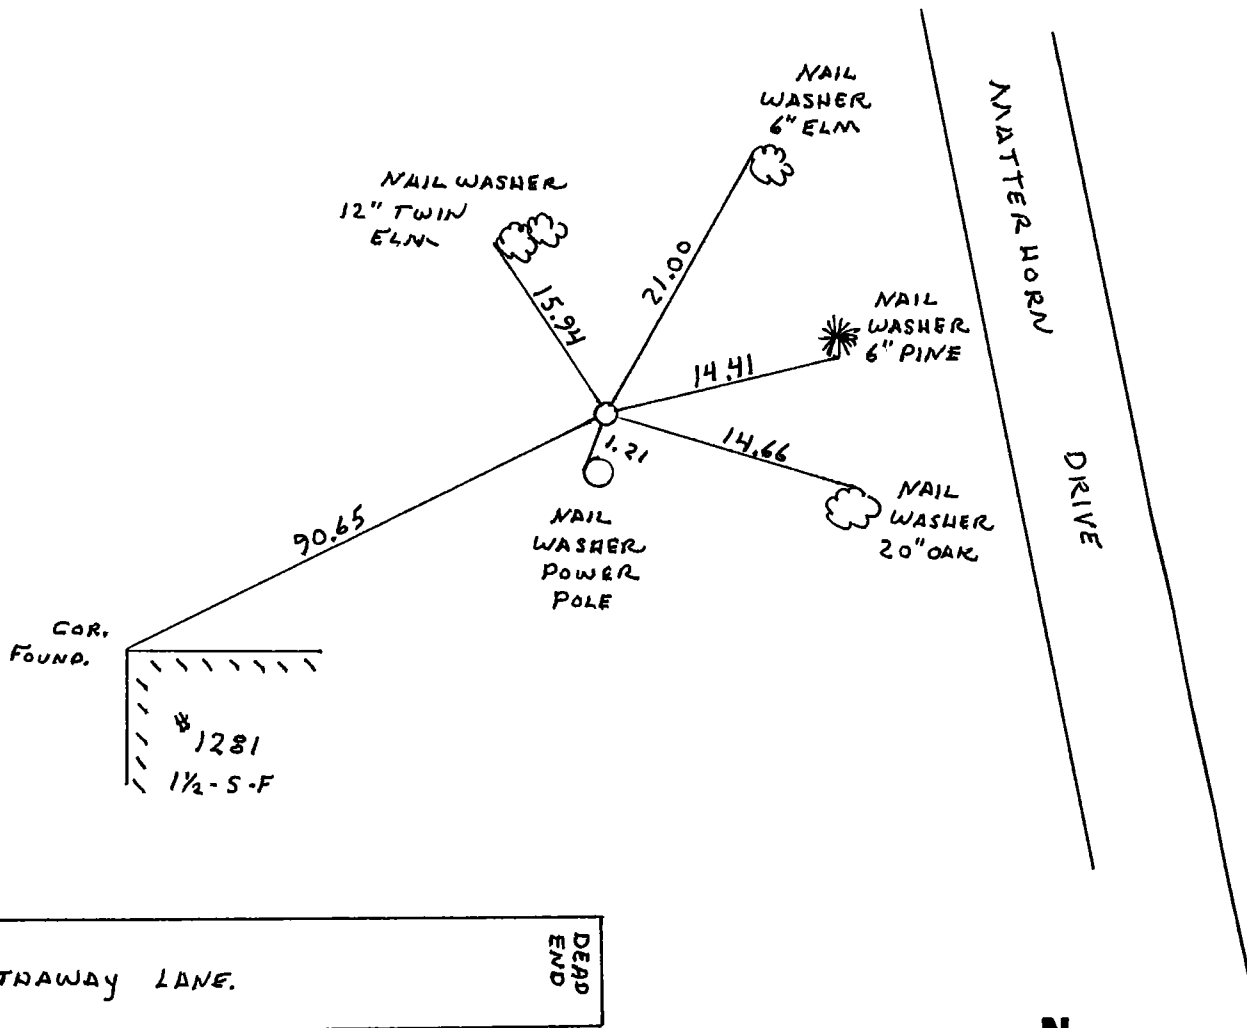

| Revised date | Revised date | Revised date |
|--------------|--------------|--------------|
| 7-1-66       |              |              |
| 8-19-70      |              |              |
| 6-26-74      |              |              |
| 6-30-86      |              |              |
| 7-25-89      |              |              |
|              |              |              |
|              |              |              |

