

CERTIFICATE OF LOCATION OF GOVERNMENT CORNER

County of Anoka

State of Minnesota



Northwest Corner of Sec. 25 Township 30 Range 24

On the 10th day of April, 1943, the described corner was evidenced by a chiseled 'X' in the concrete

and to perpetuate the location of said corner, at the exact location thereof, a permanent marker was placed consisting of a cast iron monument

AND on the ___ day of _____, _____, said permanent marker was _____

Updated reference ties are as shown below.

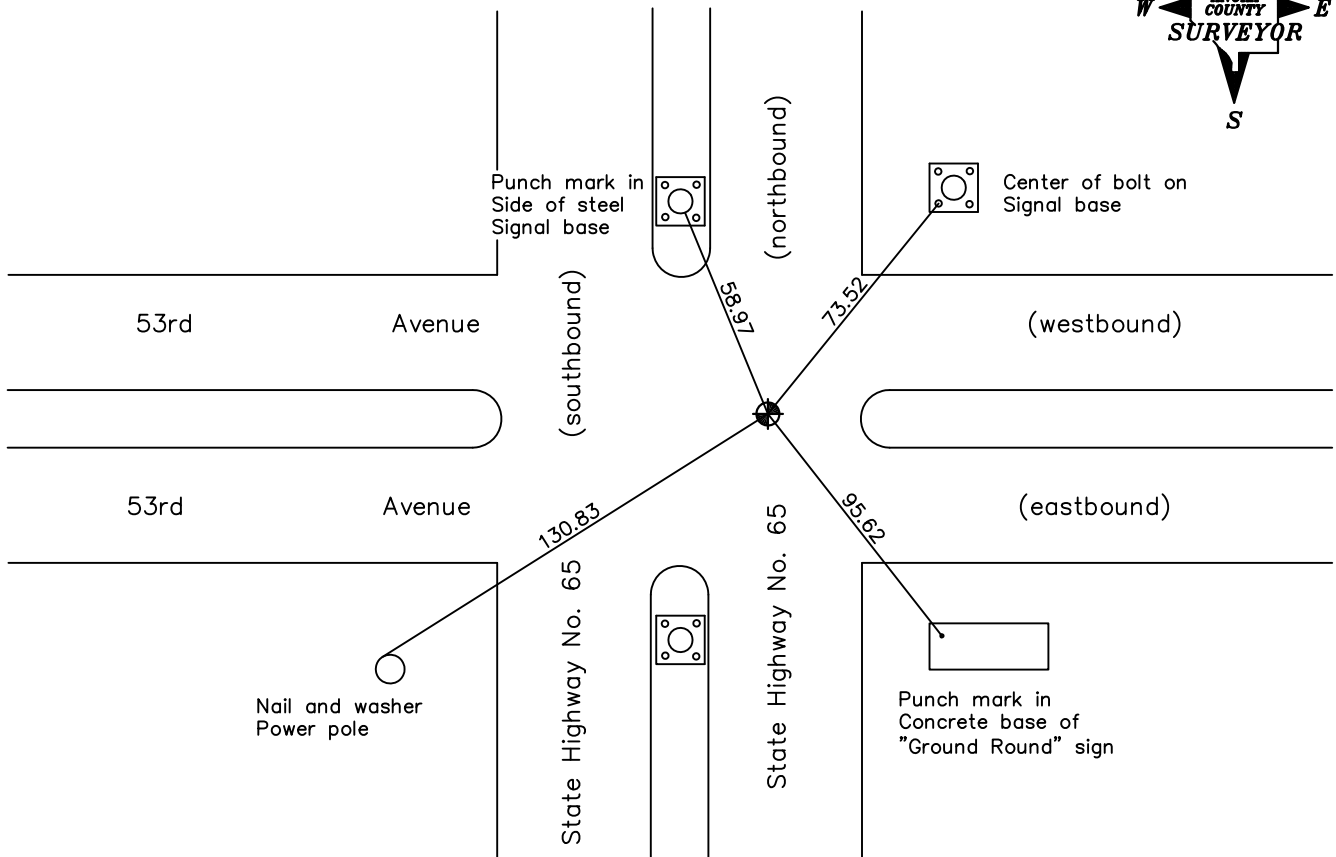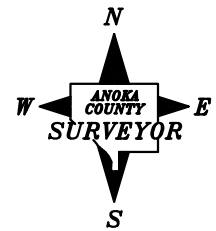

Revised date

6/30/86
8/04/89
10/24/90

N.A.D. 1983 Coordinates
(1996 Adjustment)

County Project Coordinates
Northing <u>Not available</u>
Easting _____
Date _____

I hereby certify that this United States public land survey monument record is correct and complete to the best of my knowledge and belief.

_____ Date _____
 _____, Anoka County Surveyor
 Minnesota License Number _____