

CERTIFICATE OF LOCATION OF GOVERNMENT CORNER

County of Anoka

State of Minnesota


South 1/4 Corner of Sec. 23 Township 30 Range 24

On the 8th day of September, 1961, the described corner was evidenced by a 60d spike

and to perpetuate the location of said corner, at the exact location thereof, a permanent marker was placed consisting of a cast iron monument

AND on the 27th day of October, 2014, said permanent marker was found and the ties were updated

Updated reference ties are as shown below.

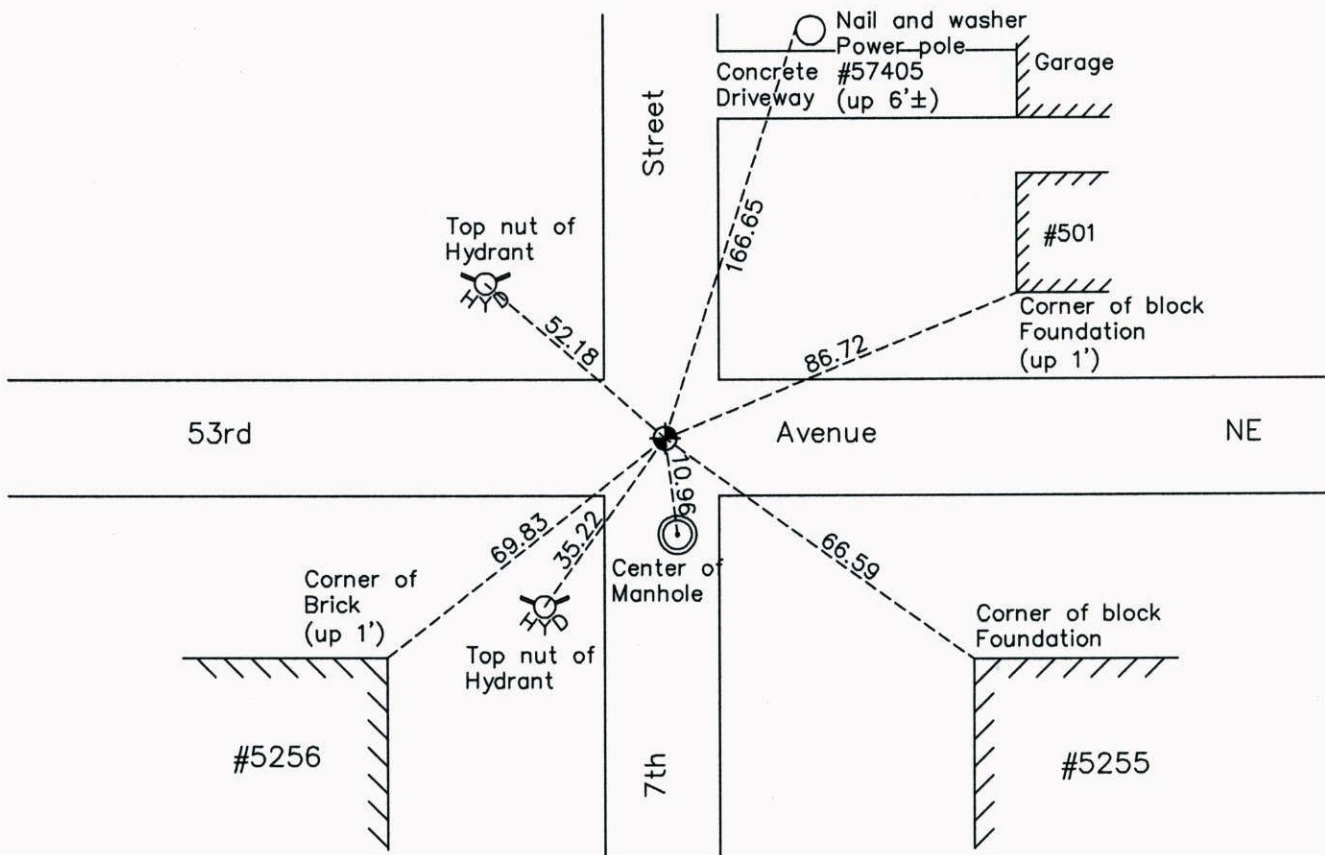

N
W ANOKA COUNTY SURVEYOR E
S

Revision Date 3/27/15

N.A.D. 1983 Coordinates
(1996 Adjustment)

County Project Coordinates	
Northing	110637.1718
Easting	502307.7079
Date	7/22/03

I hereby certify that this United States public land survey monument record is correct and complete to the best of my knowledge and belief.

Larry D. Hoium Date 3/27/15

Larry D. Hoium, Anoka County Surveyor
Minnesota License Number 18165