

CERTIFICATE OF LOCATION OF GOVERNMENT CORNER

County of Anoka


State of Minnesota

W 16TH OF NW 1/4 Corner of Sec. 26 Township 30 Range 24

I hereby certify that on the _____ day of _____, 19____, I found the described corner which was evidenced by _____

and I further certify that to perpetuate the location of said corner, I did, at the exact location thereof, place a permanent marker consisting of P. K. NAIL

which reference or witness monuments are located in the manner following:

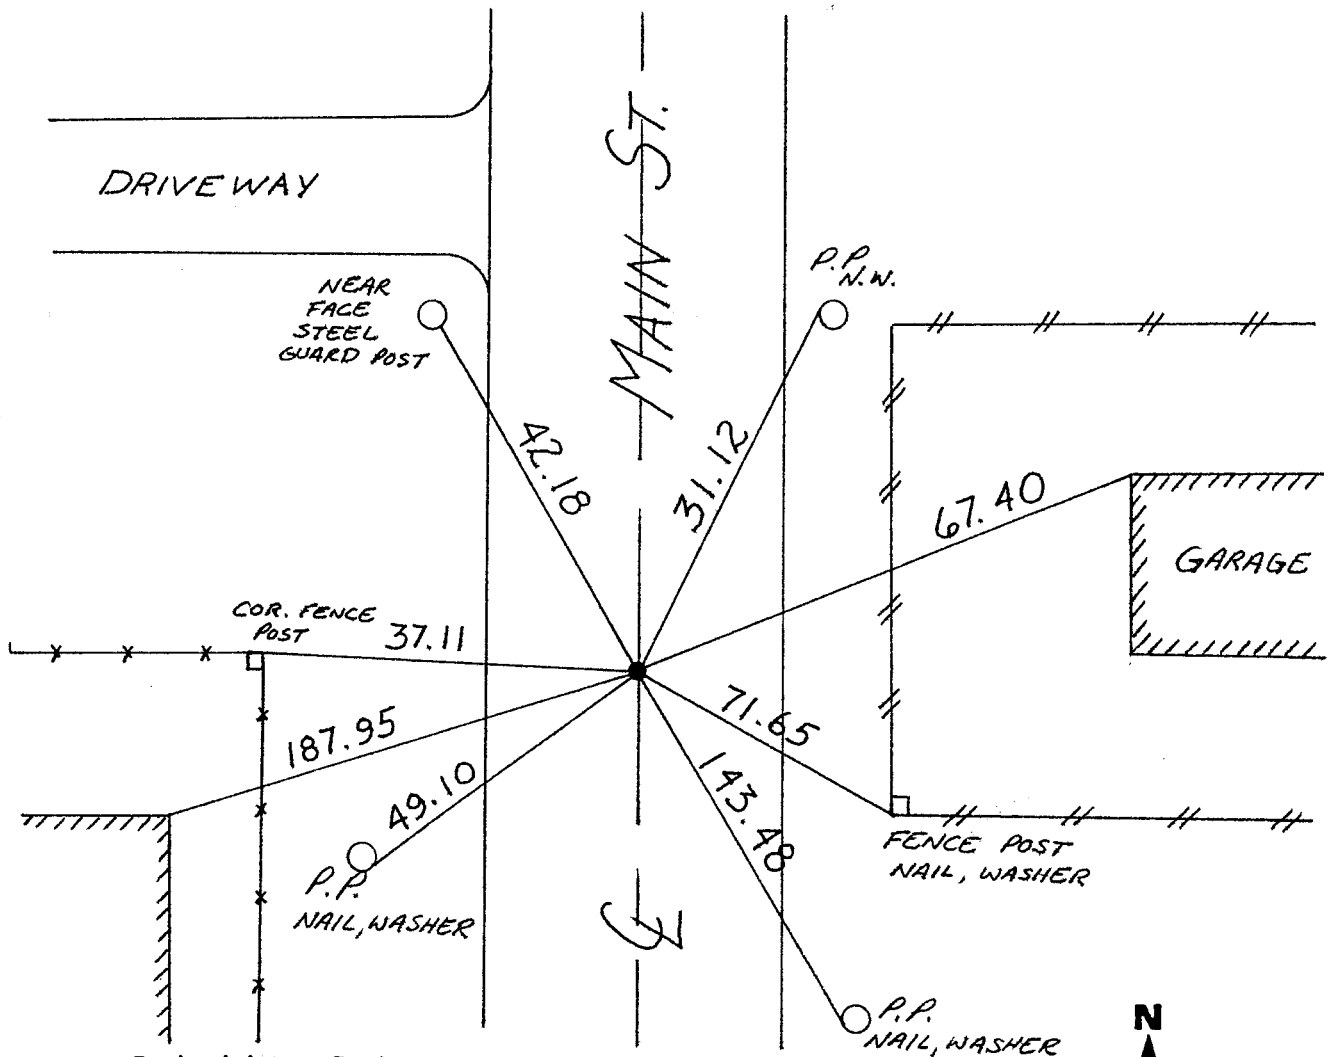

Revised date	Revised date	Revised date
7-24-89		
7-26-94		

