

CERTIFICATE OF LOCATION OF GOVERNMENT CORNER

County of Anoka

State of Minnesota



North 1/4 Corner of Sec. 36 Township 30 Range 24

On the 11th day of April, 1962, the described corner was evidenced by a 1" iron pipe

and to perpetuate the location of said corner, at the exact location thereof, a permanent marker was placed consisting of a cast iron monument

AND on the 4th day of November, 2014, said permanent marker was found and the ties were updated

Updated reference ties are as shown below.

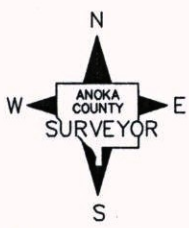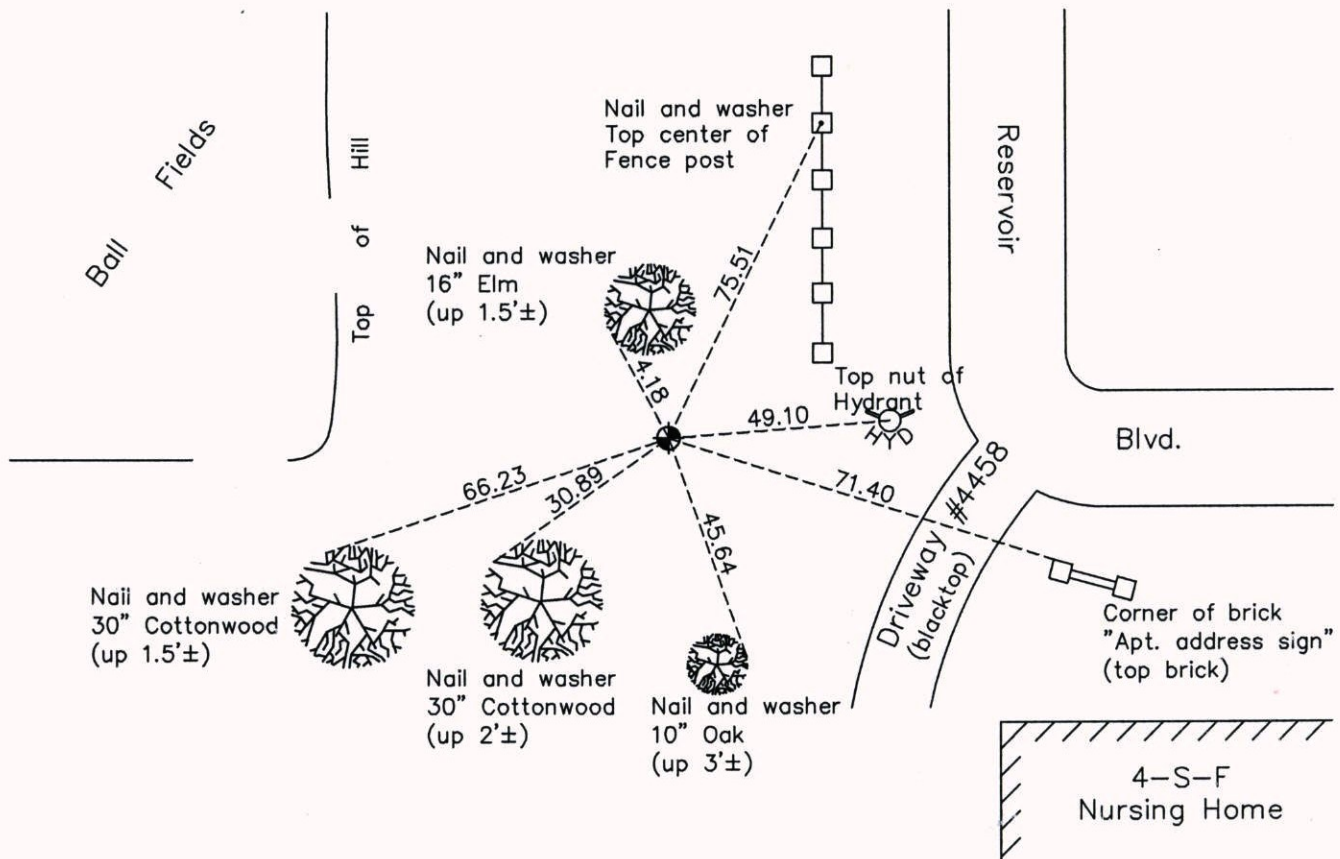

Revision Date
3/30/15

N.A.D. 1983 Coordinates
(1996 Adjustment)

County Project Coordinates	
Northing	105352.8517
Easting	507608.5956
Date	8/21/03

I hereby certify that this United States public land survey monument record is correct and complete to the best of my knowledge and belief.

Larry D. Hoium Date 3/30/15
 Larry D. Hoium, Anoka County Surveyor
 Minnesota License Number 18165