

CERTIFICATE OF LOCATION OF GOVERNMENT CORNER

County of Anoka

State of Minnesota


Witness Corner of Sec. 36 Township 30 Range 24
(on east line of section)

On the 13th day of August, 1960, the described corner was evidenced by an 8"X8"
granite monument

and to perpetuate the location of said corner, at the exact location thereof, a permanent marker was placed consisting of a cast iron monument under a fence with a Ramsey County sign 1' North and 0.5' East

AND on the 4th day of November, 2014, said permanent marker was found with fence gone
and the ties were updated

Updated reference ties are as shown below.

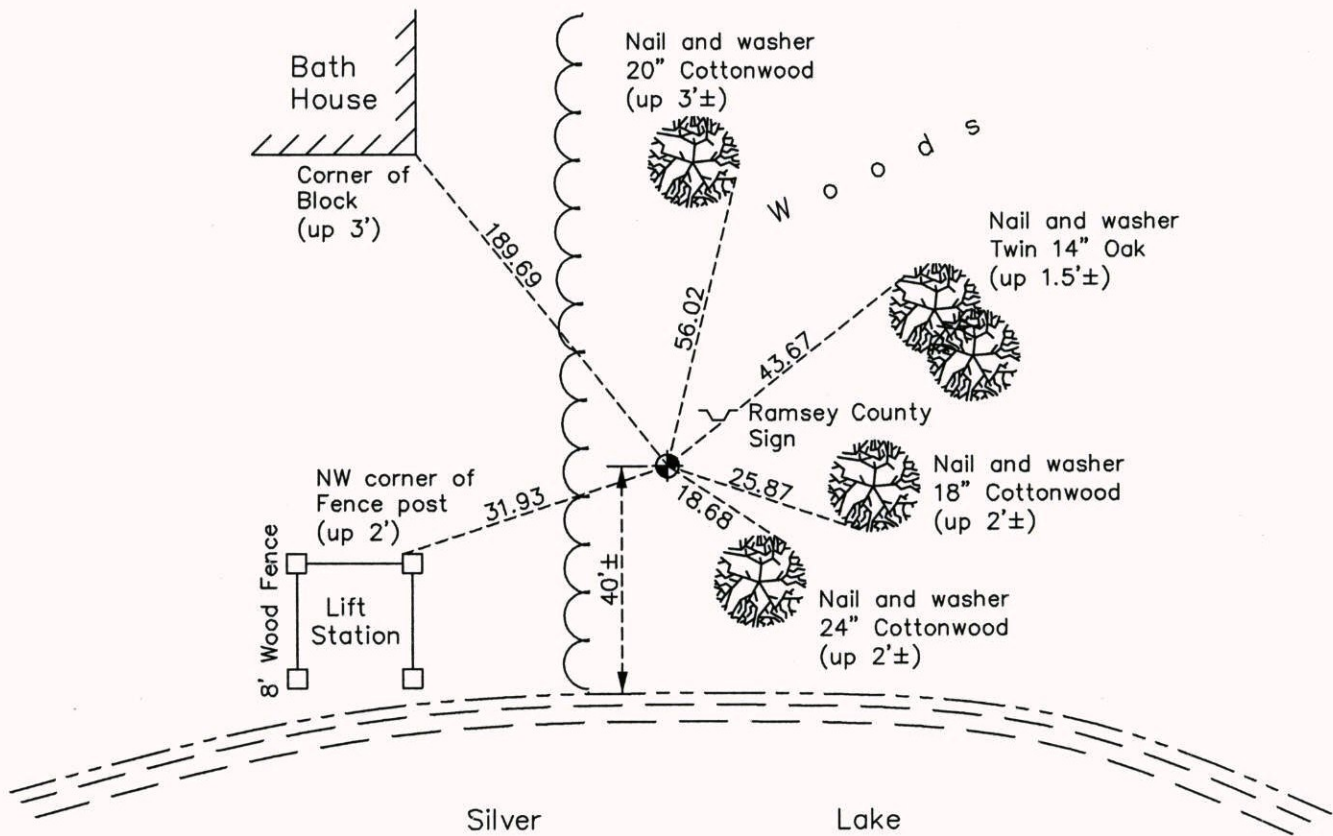

Revision Date
3/31/15

N.A.D. 1983 Coordinates
(1996 Adjustment)

County Project Coordinates	
Northing	<u>103878.4654</u>
Easting	<u>510252.5343</u>
Date	<u>1/04/05</u>

I hereby certify that this United States public land survey monument record is correct and complete to the best of my knowledge and belief.

Larry D. Hoium Date 3/31/15

Larry D. Hoium, Anoka County Surveyor
Minnesota License Number 18165