

# CERTIFICATE OF LOCATION OF GOVERNMENT CORNER

County of Anoka

State of Minnesota


## South 1/4 Corner of Sec. 35 Township 30 Range 24

On the 24th day of August, 1978, the described corner was evidenced by a brass cap

and to perpetuate the location of said corner, at the exact location thereof, a permanent marker was placed consisting of a cast iron monument

AND on the 3rd day of November, 2014, said permanent marker was found and the ties  
were updated

Updated reference ties are as shown below.

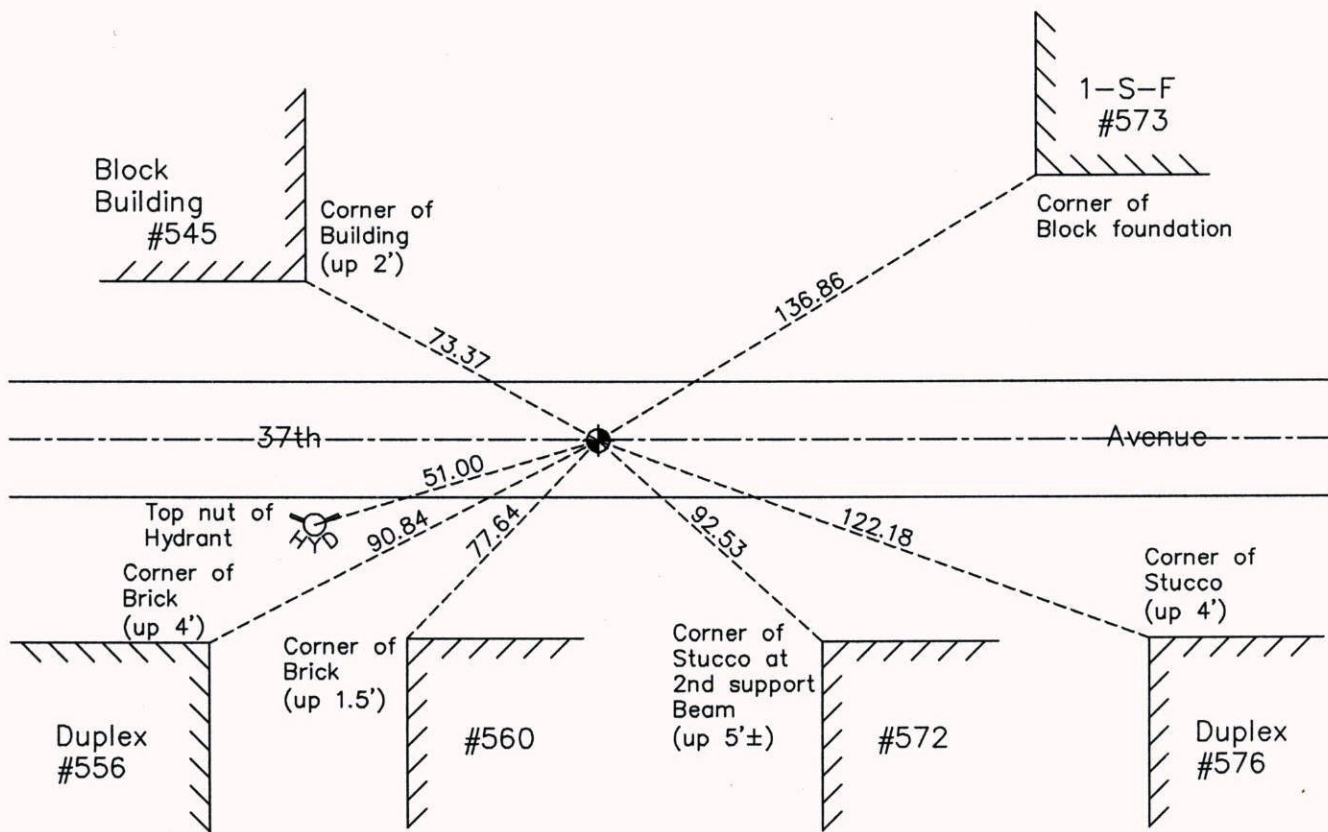

Revision Date

3/31/15

N.A.D. 1983 Coordinates  
(1996 Adjustment)

County Project Coordinates

Northing	100098.7189
Easting	502355.0631
Date	8/21/03

I hereby certify that this United States public land survey monument record is correct and complete to the best of my knowledge and belief.

Date 3/31/15  
 Larry D. Hoium, Anoka County Surveyor  
 Minnesota License Number 18165