

# CERTIFICATE OF LOCATION OF GOVERNMENT CORNER

County of Anoka

State of Minnesota


Witness Corner of Sec. 6 Township 32 Range 24  
 (on north line of section east of Rum River)

On the 4th day of May, 1966, the described corner was evidenced by area resurvey

and to perpetuate the location of said corner, at the exact location thereof, a permanent marker was placed consisting of a cast iron monument

AND on the 29th day of October, 2010, said permanent marker was found down 1'± with a 'T' post on north side and the ties were updated. On 5/06/11 a sign & post was set on west side.

Updated reference ties are as shown below.

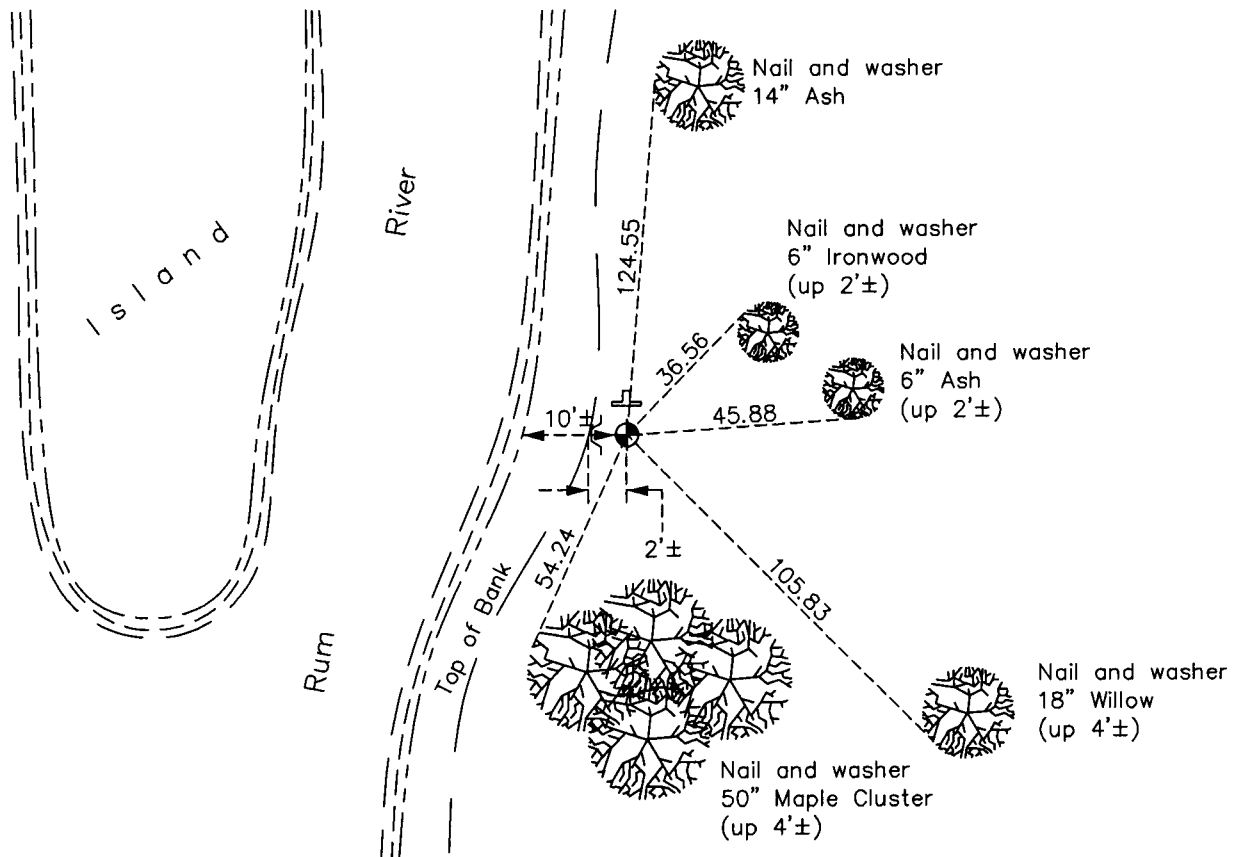

N  
  
 ANOKA COUNTY SURVEYOR  
 S

Revision Date  
8/02/11

N.A.D. 1983 Coordinates  
 (1996 Adjustment)

County Project Coordinates	
Northing	196077.1771
Easting	471575.5754
Date	12/15/00

I hereby certify that this United States public land survey monument record is correct and complete to the best of my knowledge and belief.

*Larry D. Hoium* Date 8/02/11

Larry D. Hoium, Anoka County Surveyor  
 Minnesota License Number 18165

# HISTORY OF GOVERNMENT CORNER

Page No. 9A

County of Anoka

State of Minnesota

Witness Corner of Sec. 6 Township 32 Range 24  
(on north line of section east of Rum River)

## **CORNER HISTORY:**

May 4, 1966 - Set cast iron monument down 0.2'± on north line of Section 6. Established face ties for approximate location purposes only. Landowner would not allow the use of nails and washers.

August 3, 1971 - Landowner would not allow us to access the corner.

May 31, 1984 - Found cast iron monument and updated ties.

June 16, 1992 - Found cast iron monument and updated ties.

December 15, 2000 - Found cast iron monument and established NAD 1983 (1996 Adjustment) Anoka County Project Coordinates by Static GPS methods. Updated ties.

October 29, 2010 - Found cast iron monument down 1'± with a "T" fence post on north side of monument.

May 6, 2011 - Set sign and post on west side of cast iron monument.