

CERTIFICATE OF LOCATION OF GOVERNMENT CORNER

County of Anoka

State of Minnesota



Southeast Corner of Sec. 6 Township 32 Range 24

On the 27th day of May, 1966, the described corner was evidenced by area resurvey

and to perpetuate the location of said corner, at the exact location thereof, a permanent marker was placed consisting of a red and white iron pipe

AND on the 17th day of December, 2010, said permanent marker was found up 3'± and the ties were updated. On February 17, 2011 a sign and post was set 1'± west of the iron pipe.

Updated reference ties are as shown below.

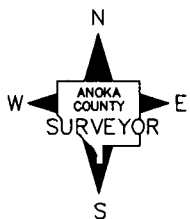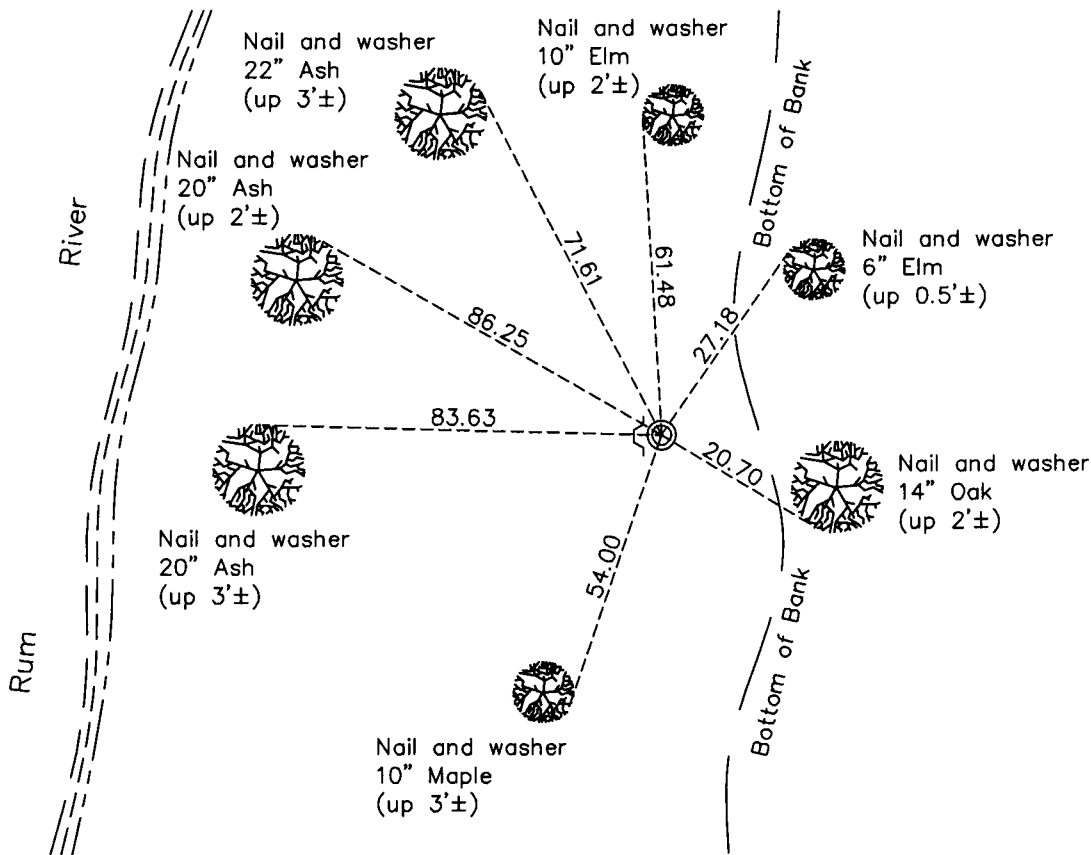

Revision Date
4/14/11

N.A.D. 1983 Coordinates
(1996 Adjustment)

County Project Coordinates	
Northing	<u>190891.4562</u>
Easting	<u>474071.3528</u>
Date	<u>12/06/00</u>

I hereby certify that this United States public land survey monument record is correct and complete to the best of my knowledge and belief.

Larry D. Hoium Date 4/14/11

Larry D. Hoium, Anoka County Surveyor

Minnesota License Number 18165

HISTORY OF GOVERNMENT CORNER

Page No. 26

County of Anoka

State of Minnesota

Southeast Corner of Sec. 6 Township 32 Range 24

CORNER HISTORY:

May 27, 1966 - Set red and white iron pipe using area resurvey and established ties to monument. Iron pipe is up 3'± in swamp.

Summer 1968 - Area too wet to access corner.

June 26, 1972 - Found red and white iron pipe and updated ties.

December 11, 1973 - Replaced red and white iron pipe with a new red and white iron pipe. Updated ties.

May 26, 1976 - Found red and white iron pipe and updated ties.

May 31, 1979 - Found red and white iron pipe and updated ties.

July 7, 1982 - Found red and white iron pipe and updated ties.

June 5, 1985 - Found red and white iron pipe and updated ties.

August 17, 1988 - Found red and white iron pipe and updated ties.

December 6, 2000 - Found red and white iron pipe and established NAD 1983 (1996 Adjustment) Anoka County Project Coordinates by Static GPS methods. Updated ties.

December 17, 2010 - Found red and white iron pipe up 3'± and updated ties.

February 17, 2011 - Set sign and post 1'± west of red and white iron pipe.