

CERTIFICATE OF LOCATION OF GOVERNMENT CORNER

County of Anoka

State of Minnesota



North 1/4 Corner of Sec. 15 Township 32 Range 24

On the 29th day of January, 1964, the described corner was evidenced by area resurvey

and to perpetuate the location of said corner, at the exact location thereof, a permanent marker was placed consisting of a red and white iron pipe up 3 1/2"

AND on the 18th day of January, 2011, said permanent marker was found with paint worn off and the ties were updated. On 2/18/11 a sign & post was set 1'± north of iron pipe.

Updated reference ties are as shown below.

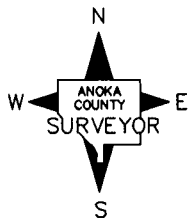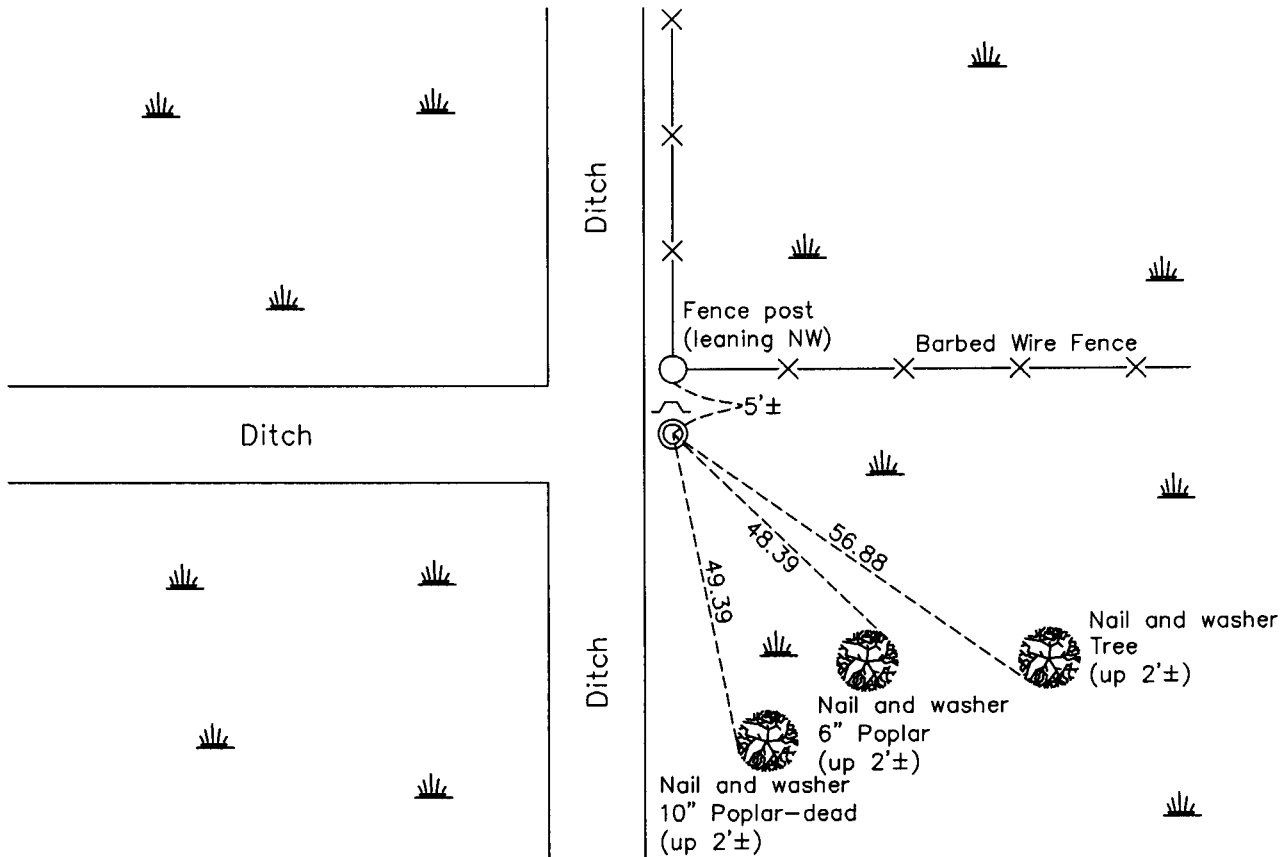

Revision Date

4/21/11

N.A.D. 1983 Coordinates
(1996 Adjustment)

County Project Coordinates	
Northing	185579.5786
Easting	487286.9328
Date	1/25/01

I hereby certify that this United States public land survey monument record is correct and complete to the best of my knowledge and belief.

Larry D. Hoium Date 4/21/11

Larry D. Hoium, Anoka County Surveyor

Minnesota License Number 18165

HISTORY OF GOVERNMENT CORNER

County of Anoka

State of Minnesota

North 1/4 Corner of Sec. 15 Township 32 Range 24

CORNER HISTORY:

January 29, 1964 - Set 1" X 9' iron pipe up 4'± using area resurvey and established ties to monument. Top 4' of monument has 6" red and white bands.

July 12, 1968 - Found 1" red and white iron pipe and updated ties.

June 26, 1972 - Found 1" red and white iron pipe and updated ties.

January 19, 1978 - Found 1" red and white iron pipe and updated ties.

June 6, 1985 - Found 1" red and white iron pipe and updated ties.

August 15, 1988 - Found 1" red and white iron pipe and updated ties.

January 18, 1994 - Found 1" red and white iron pipe and updated ties.

January 25, 2001 - Found 1" iron pipe (paint worn off) up 3.5'± and established NAD 1983 (1996 Adjustment) Anoka County Project Coordinates by Static GPS methods. Updated ties.

January 18, 2011 - Found 1" iron pipe and updated ties.

February 18, 2011 - Set sign and post 1'± north of 1" white iron pipe.