

CERTIFICATE OF LOCATION OF GOVERNMENT CORNER

County of Anoka

State of Minnesota



Northwest Corner of Sec. 16 Township 32 Range 24

On the 6th day of March, 1962, the described corner was evidenced by a granite monument

and to perpetuate the location of said corner, at the exact location thereof, a permanent marker was placed consisting of a cast iron monument

AND on the 15th day of February, 2011, said permanent marker was found and the ties were updated

Updated reference ties are as shown below.

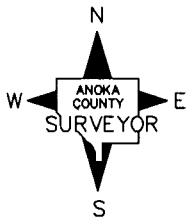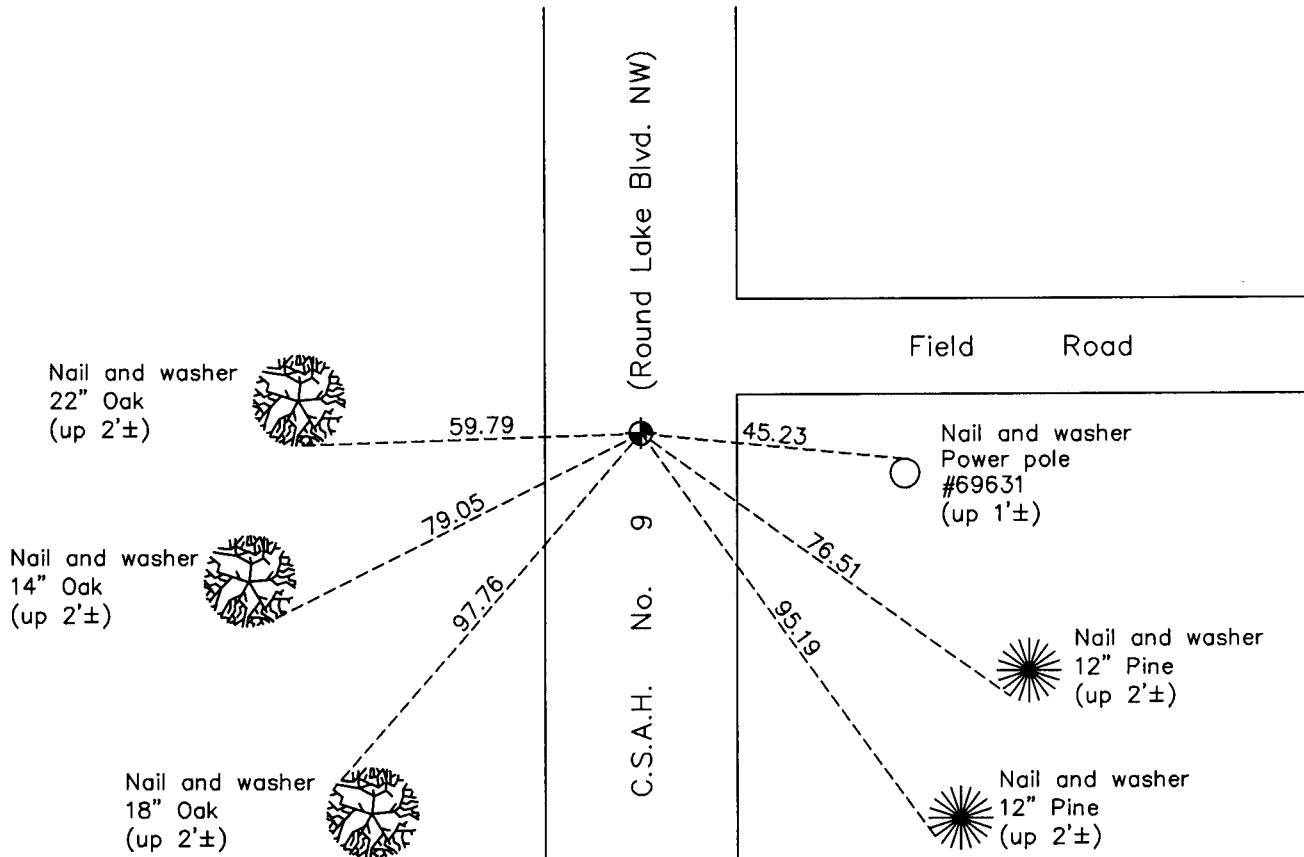

Revision Date
4/22/11

N.A.D. 1983 Coordinates
(1996 Adjustment)

County Project Coordinates	
Northing	<u>185576.8881</u>
Easting	<u>479345.5540</u>
Date	<u>10/03/00</u>

I hereby certify that this United States public land survey monument record is correct and complete to the best of my knowledge and belief.

Larry D. Hoium Date 4/22/11

Larry D. Hoium, Anoka County Surveyor

Minnesota License Number 18165

HISTORY OF GOVERNMENT CORNER

Page No. 45

County of Anoka

State of Minnesota

Northwest Corner of Sec. 16 Township 32 Range 24

CORNER HISTORY:

October 4, 1954 - Anoka County Highway Department found 6" X 6" granite monument. Established ties to monument.

March 6, 1962 - Found granite monument down 1' with iron pipe on north side and updated ties.

August 22, 1964 - Found granite monument and updated ties.

June 1965 - Set cast iron monument and updated ties.

July 9, 1968 - Found cast iron monument and updated ties.

June 23, 1972 - Found cast iron monument and updated ties.

May 28, 1976 - Found cast iron monument and updated ties.

June 1, 1979 - Found cast iron monument and updated ties.

September 3, 1982 - Found cast iron monument and updated ties.

May 29, 1985 - Found cast iron monument and updated ties.

August 9, 1988 - Found cast iron monument and updated ties.

July 15, 1993 - Found cast iron monument and updated ties.

October 3, 2000 - Found cast iron monument and established NAD 1983 (1996 Adjustment) Anoka County Project Coordinates by Static GPS methods. Updated ties.

July 18, 2001 - Set construction ties and removed cast iron monument prior to road construction. (Date reset is unknown) .

February 15, 2011 - Found cast iron monument and updated ties.