

CERTIFICATE OF LOCATION OF GOVERNMENT CORNER

County of Anoka

State of Minnesota



North 1/4 Corner of Sec. 9 Township 31 Range 23

On the 9th day of November, 1973, the described corner was evidenced by area resurvey

and to perpetuate the location of said corner, at the exact location thereof, a permanent marker was placed consisting of a cast iron monument

AND on the 14th day of November, 2016, said permanent marker was replaced with a cast iron monument after road construction and the ties were updated

Updated reference ties are as shown below.

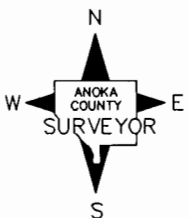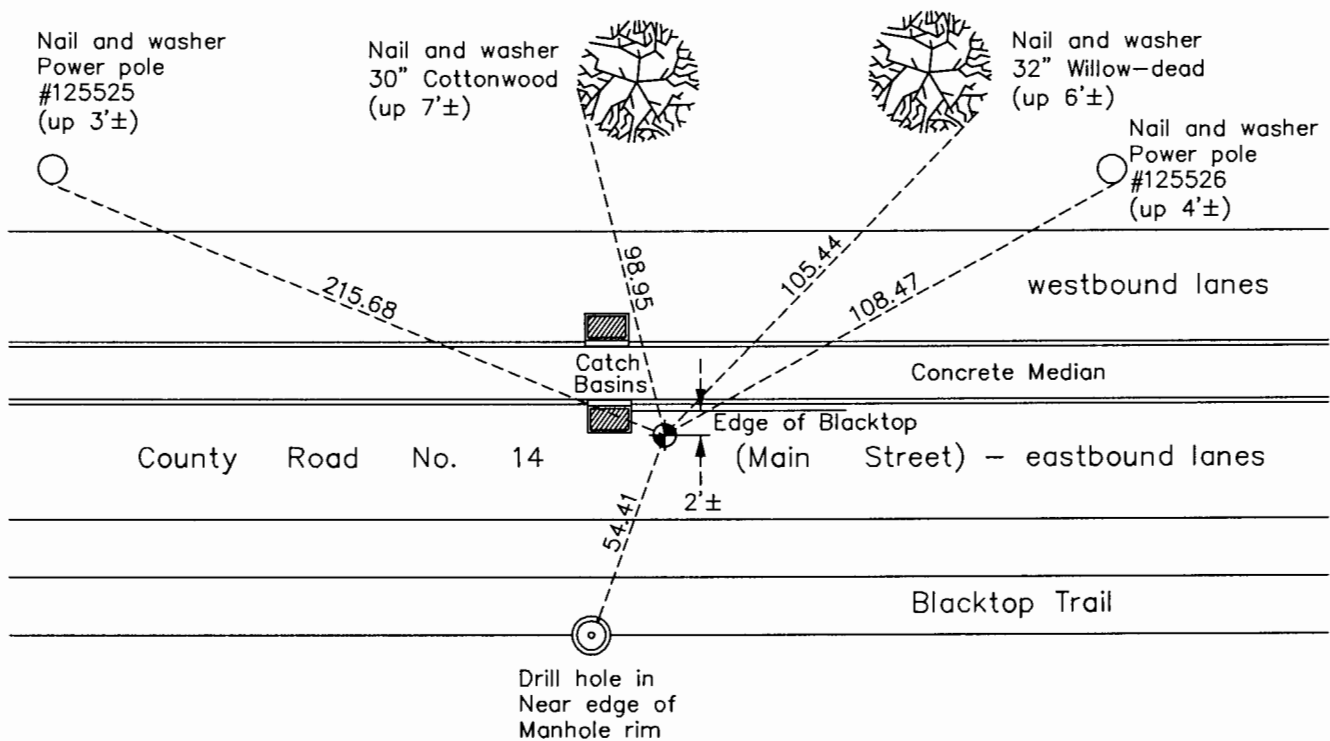

Revision Date
12/22/16

N.A.D. 1983 Coordinates
(1996 Adjustment)

County Project Coordinates	
Northing	159038.6176
Easting	513535.2675
Date	9/03/98

I hereby certify that this United States public land survey monument record is correct and complete to the best of my knowledge and belief.

Larry D. Hoium Date 12/22/16

Larry D. Hoium, Anoka County Surveyor

Minnesota License Number 18165