

CERTIFICATE OF LOCATION OF GOVERNMENT CORNER

County of Anoka

State of Minnesota


South 1/4 Corner of Sec. 36 Township 31 Range 23

On the 11th day of July, 1963, the described corner was evidenced by area resurvey

and to perpetuate the location of said corner, at the exact location thereof, a permanent marker was placed consisting of a cast iron monument

AND on the 28th day of July, 2016, said permanent marker was found and raised to flush with the surface and the ties were updated

Updated reference ties are as shown below.

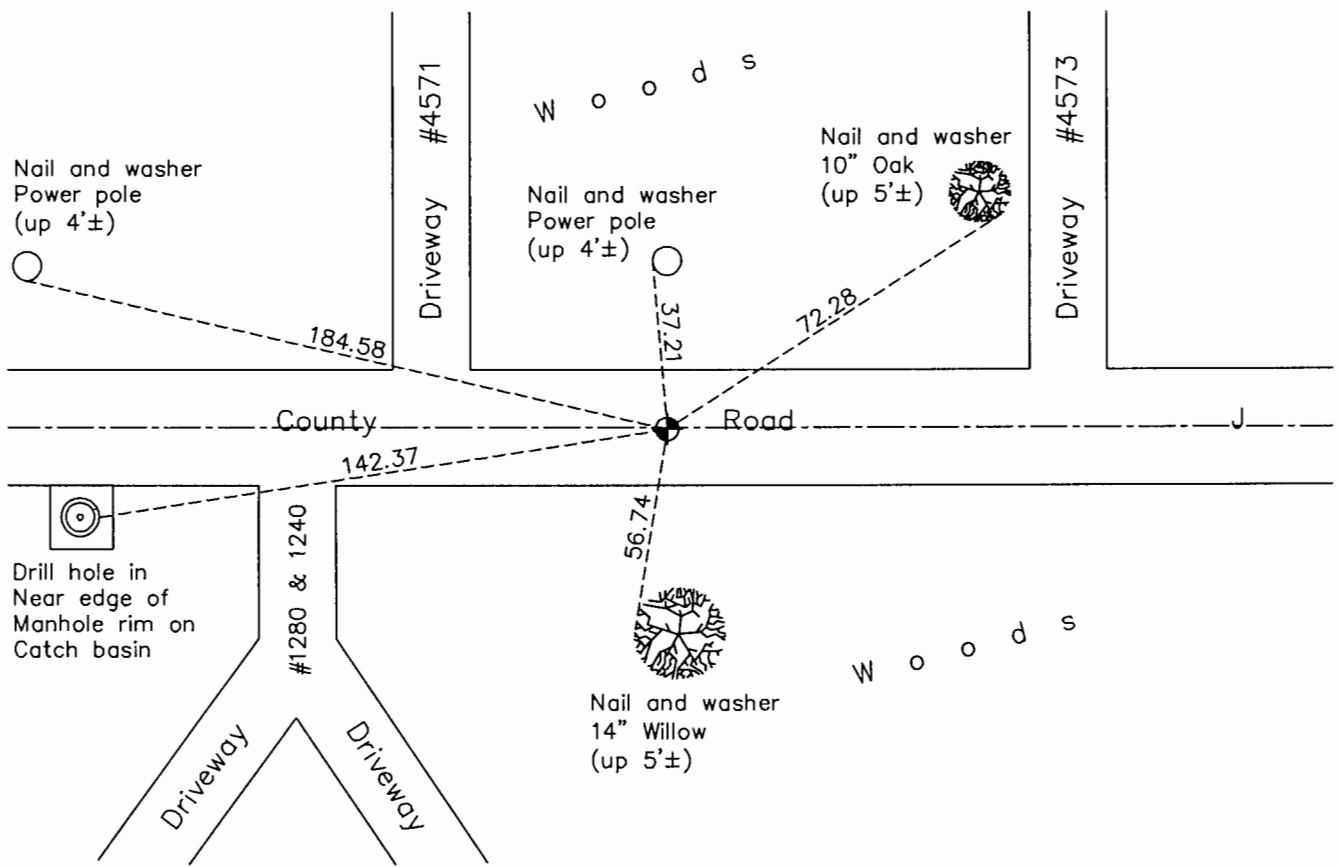

N
W ANOKA COUNTY SURVEYOR E
S

Revision Date
12/27/16

N.A.D. 1983 Coordinates
(1996 Adjustment)

County Project Coordinates	
Northing	132452.6685
Easting	529199.0500
Date	10/19/98

I hereby certify that this United States public land survey monument record is correct and complete to the best of my knowledge and belief.

Larry D. Hoium Date 12/27/16
 Larry D. Hoium, Anoka County Surveyor
 Minnesota License Number 18165