

CERTIFICATE OF LOCATION OF GOVERNMENT CORNER

County of Anoka

State of Minnesota


NORTH QTR. Corner of Sec. 34 Township 31 Range 22

I hereby certify that on the 17 day of JUNE, 1965, I found the described corner which was evidenced by RM KNUDSON TIES


and I further certify that to perpetuate the location of said corner, I did, at the exact location thereof, place a permanent marker consisting of CAST IRON MON. STEEL POST ON WEST SIDE

which reference or witness monuments are located in the manner following:

N.A.D.	1983	Co-ordinates
County Project	Co-ordinates	
Northing	<u>137737.8579</u>	
Easting	<u>550451.3259</u>	
State Plane	Co-ordinates	
Y	_____	
X	_____	
Date	_____	

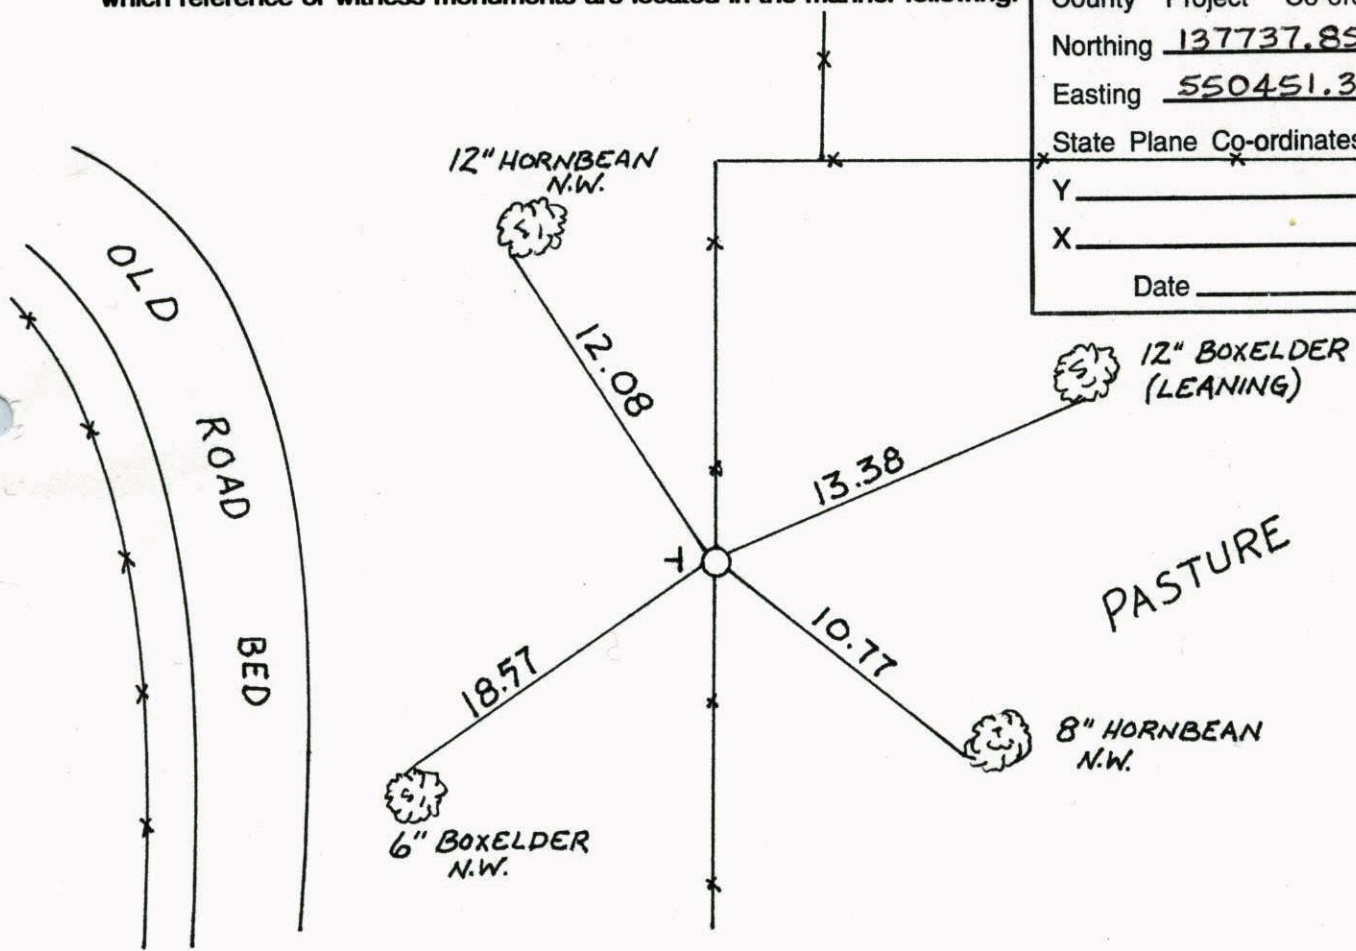


Revised date	Revised date	Revised date
7-8-96		
4-6-98		

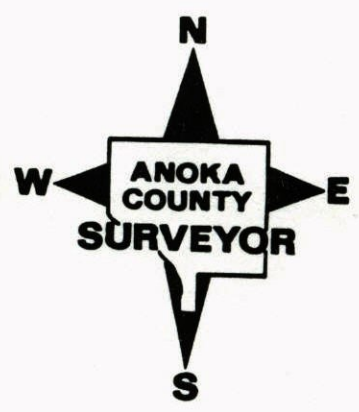


NORTH QTR. S. 34 T31 R22
CAST IRON MON.

NATIONAL PRIORITY NO. 446

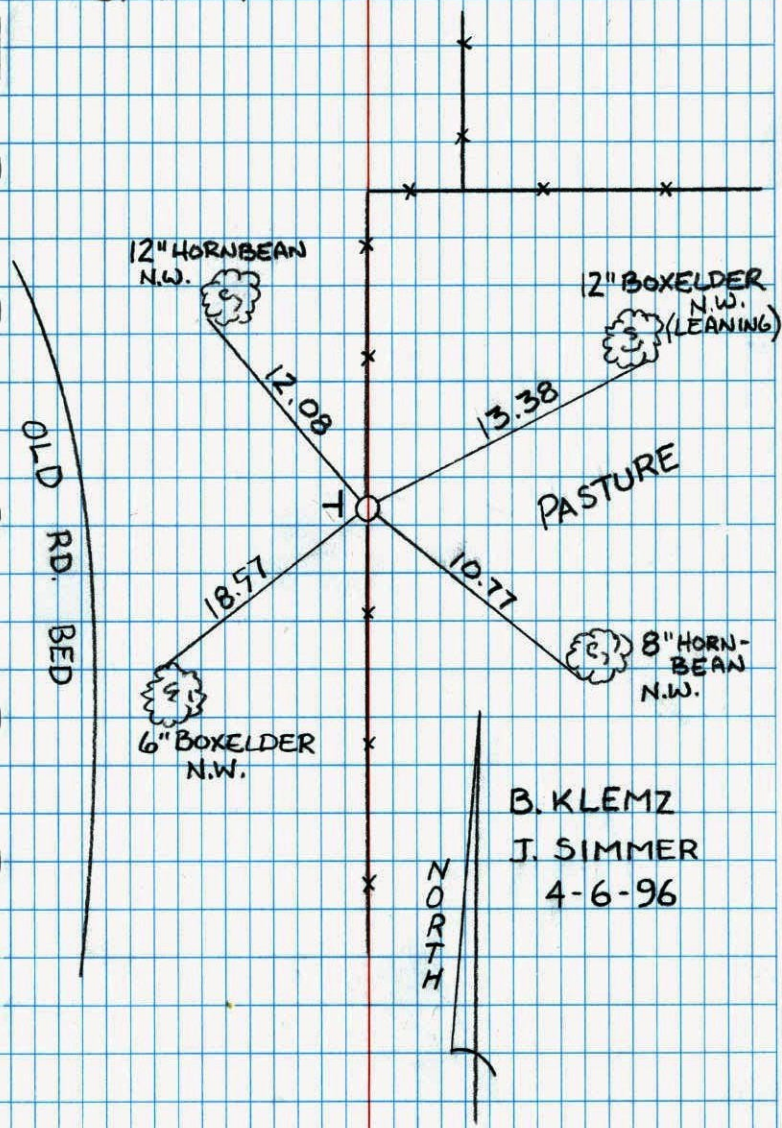

N 1/4 CORNER SEC. 34 T31, R22
RETIED CAST IRON

NATIONAL PRIORITY NO. 448

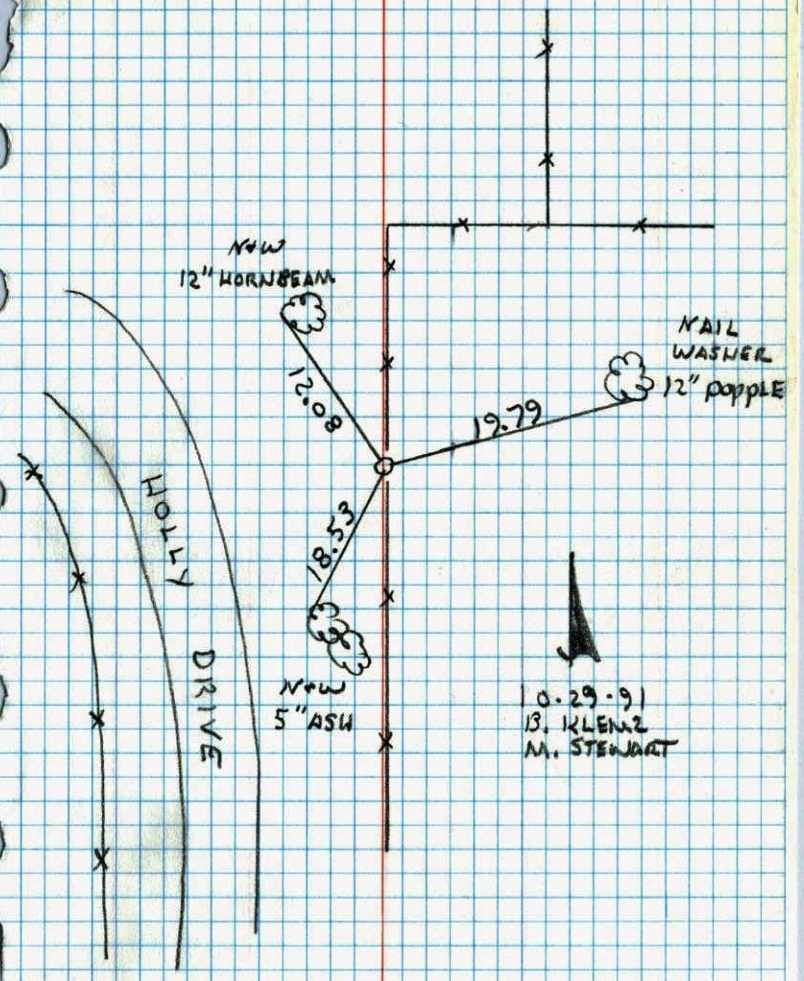


N¹/₄ Cor. Sec. 34 T31 R22

Found cast iron monument from ties
by R.M. Knudson of April 20, 1961.

C.I. is Flush and 2.5' ± West of N.S.

Fence Line.

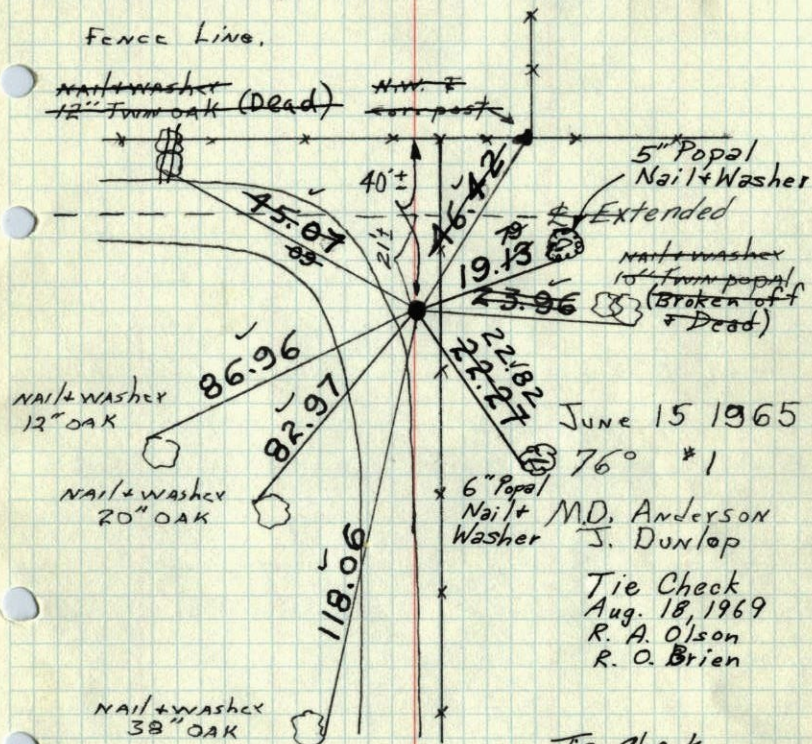

June 15 1965

76° *1

M.D. Anderson
J. Dunlop

Tie Check
Aug. 18, 1969
R. A. Olson
R. O. Brien

Tie Check



TEMPERATURE CORRECTED
AND HORIZONTALLY
TAPED MEASUREMENTS


ROLAND W. ANDERSON
COUNTY SURVEYOR
ANOKA COUNTY, MINNESOTA

N¹/₄ Cor. Sec. 34 T31 R22 1969

Found cast iron monument from ties
by R.M. Knudson of April 20, 1961.

C.I. is Flush and 2.5' ± West of N.S.

Fence Line.

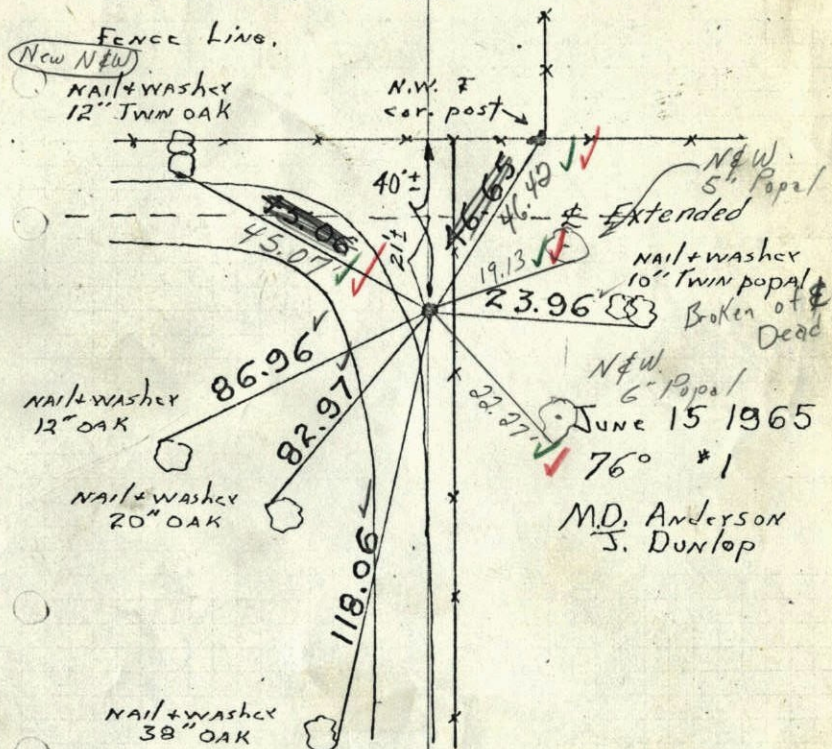

June 15 1965

76° *1

M.D. Anderson
J. Dunlop

NAIL+WASHER
38" OAK


TEMPERATURE CORRECTED
AND HORIZONTALLY
TAPED MEASUREMENTS

ROLAND W. ANDERSON
COUNTY SURVEYOR
ANOKA COUNTY, MINNESOTA

1965

N¹/₄ Cor. Sec. 34-T31-R22

found Cast Iron Monument from
ties by R.M. Knudson of Apr. 20, 1961
Cast Iron flush & 2.5'± W. of N.S.
fence

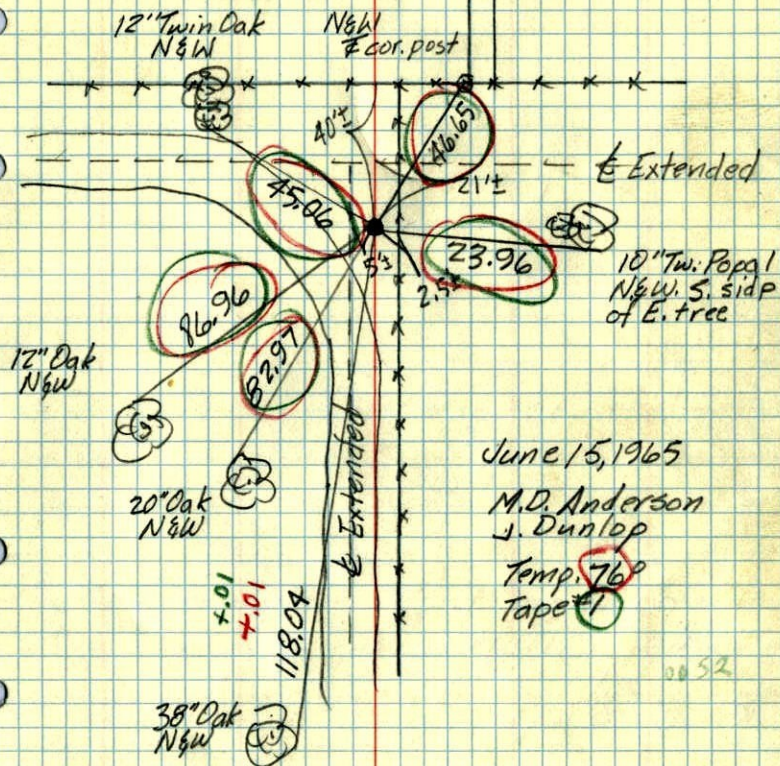


June 15, 1965
M.D. Anderson
J. Dunlop
Temp. 76°
Tape #1

1965⁴

N¹/₄ Corner Sec. 34, T31, R22

Set Cast Iron Monument

(see Survey sheet for Sect. Dimensions)

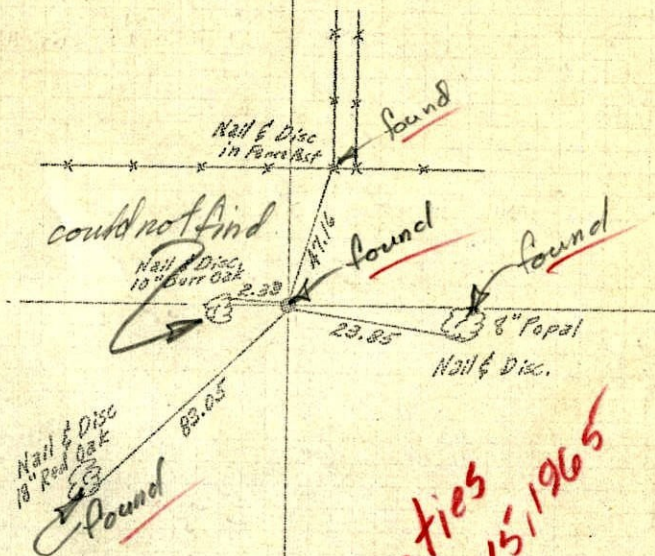

New ties
June 15, 1965
M.D.A.
J.D.


R.M. Knudson
Apr. 20, 1961

1961 64

N 1/4 Corner Sec. 34, T 31, R 22

Set Cast Iron Monument


(see Survey sheet for Sect. Dimensions)

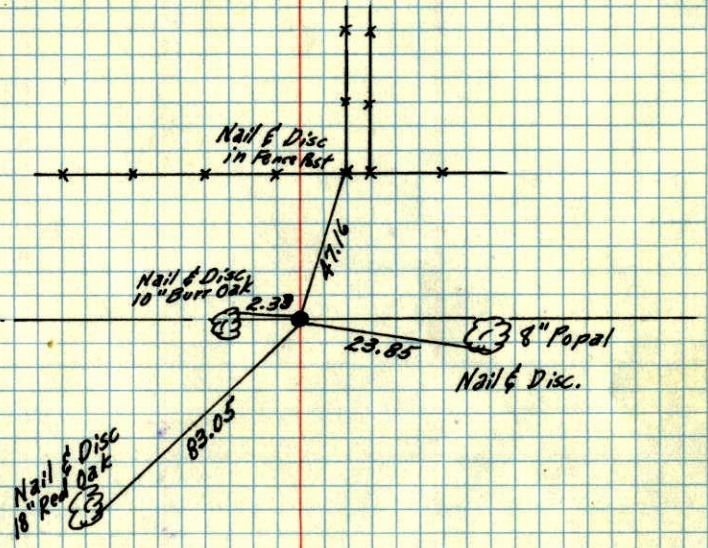

R.M. Knudsen
Apr. 20, 1961

1961

N 1/4 Cor. Sec 34-31-22
ANOKA CO.

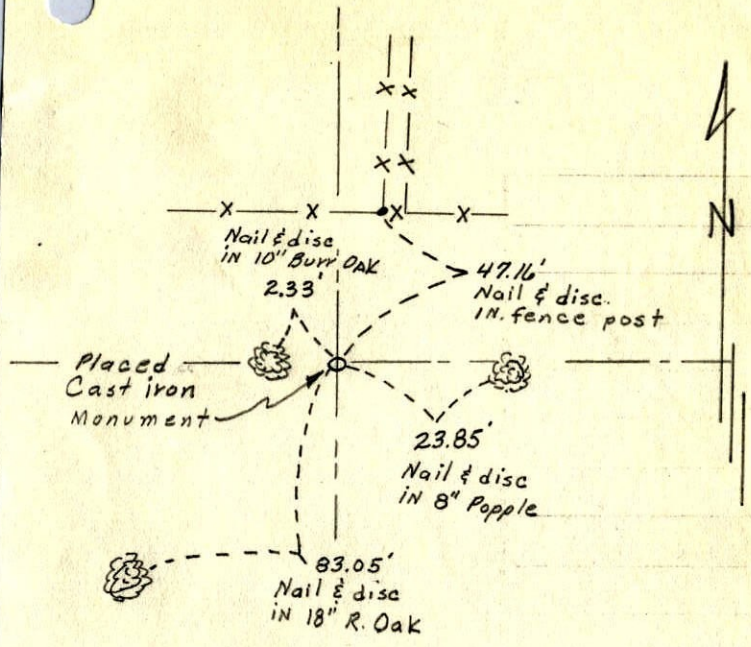

R.M. Knudsen
April 20, 1961