


W.C. ON EAST LINE OF SE 1/4 SEC. 36 - T31 - R22

FOUND 1/2" IRON PIPE AS WITNESS CORNER.
Verified by area re-survey.
REPLACED WITH CAST IRON MONUMENT. CAST
IRON IS FLUSH WITH GROUND.

BALD EAGLE LAKE

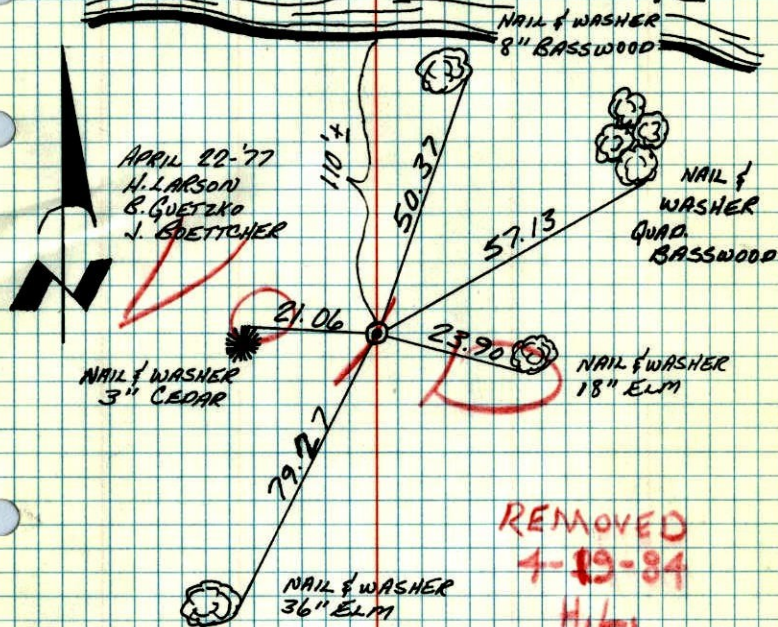

TEMPERATURE CORRECTED
AND HORIZONTALLY
TAPED MEASUREMENTS

ROLAND W. ANDERSON
COUNTY SURVEYOR
ANOKA COUNTY, MINNESOTA

W.C. on East Line of SE 1/4 Sec. 36 T31 R22

Found 1/2" iron rod as W.C. replaced
with cast iron monument. G.I. Flush

Bald Eagle Lake

